



City of Prince George History Sheet

PID:	010356193
MU:	101622
WO:	83743

Civic Address: 975 Central Street W

Legal Description: Lot: A District Lot: 936 Plan: 19765


Service Type	Diameter (mm)	Material	Invert Elev at main (m)	Invert Elev at property line (m)	Invert Elev at service end (m)	Distance into property (m)	Installation Date
Sanitary	Unknown	AC	-	596.87	-	-	January 1965
Water	100mm	PVC	296.24	596.38	-	-	June 2015
Storm	N/A	N/A	-	-	-	-	

Service Connection Location	Sanitary (m)	Storm (m)
sanitary service connected to San MH 1958	-	
Distance from downstream Stm MH - towards upstream Stm MH		

Power	Size	Communications	Size	Cable	Size	Gas	Size
BC Hydro	-	Telus	-	Shaw	-	FortisBC	-
Overhead Service		Overhead Service		Overhead Service			

Installed by: City of Prince George forces	Survey Date: -
Comments:	

NOT TO SCALE The information contained herein is for internal use only.
Not to be relied on unless confirmed by site inspection and/or investigation.

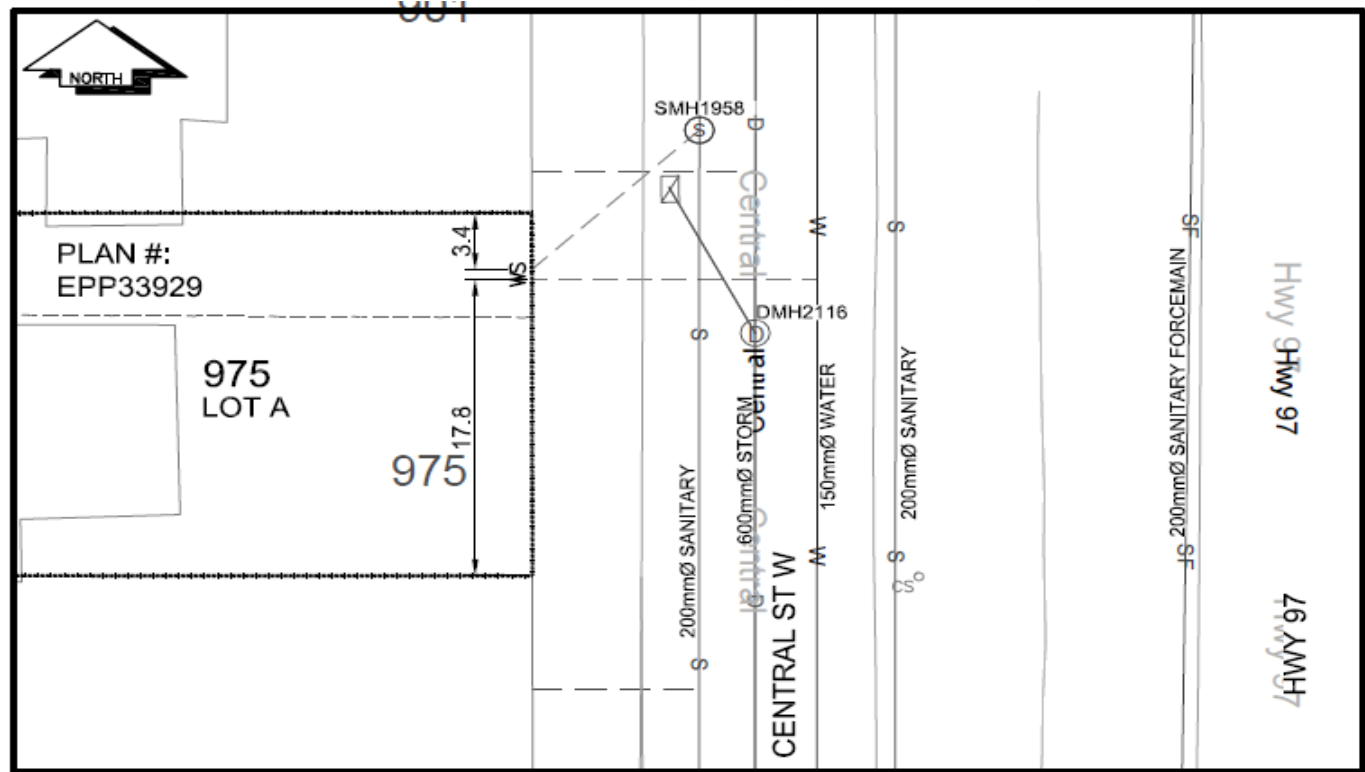

CS CURB STOP	--- WATER SERVICE	--- STORM SERVICE
CO CLEAN OUT	--- SANITARY SERVICE	--- GAS

NOT TO SCALE