



City of Prince George
History Sheet

PID:	010373250
SD/MU:	
WO:	

Civic Address: 838 - 840 Irwin St

Legal Description: Lot: A District Lot: 1429 Plan: 19686


Service Type	Diameter (mm)	Material	Invert Elev at main (m)	Depth of cut at property line (m)	Invert Elev at service end (m)	Distance into property (m)	Installation Date
Sanitary	100mm	PVC	594.51	3.40	594.96	-	May 1968
Water	20mm	Copper	-	-	-	-	June 1968
Storm	N/A	N/A	-	-	-	-	

Service Connection Location				Sanitary (m)	Storm (m)
Distance from downstream San MH	1963	towards upstream San MH	1967	46.90	
Distance from downstream Stm MH	-	towards upstream Stm MH	-		

Power	Size	Communications	Size	Cable	Size	Gas	Size
BC Hydro	-	Telus	-	Shaw	-	FortisBC	-
Overhead Service		Overhead Service		Overhead Service			

Installed by:		Survey Date:	-
Comments:	Water and sanitary service locations confirmed Feb 28, 2013		

NOT TO SCALE The information contained herein is for internal use only.
Not to be relied on unless confirmed by site inspection and/or investigation.

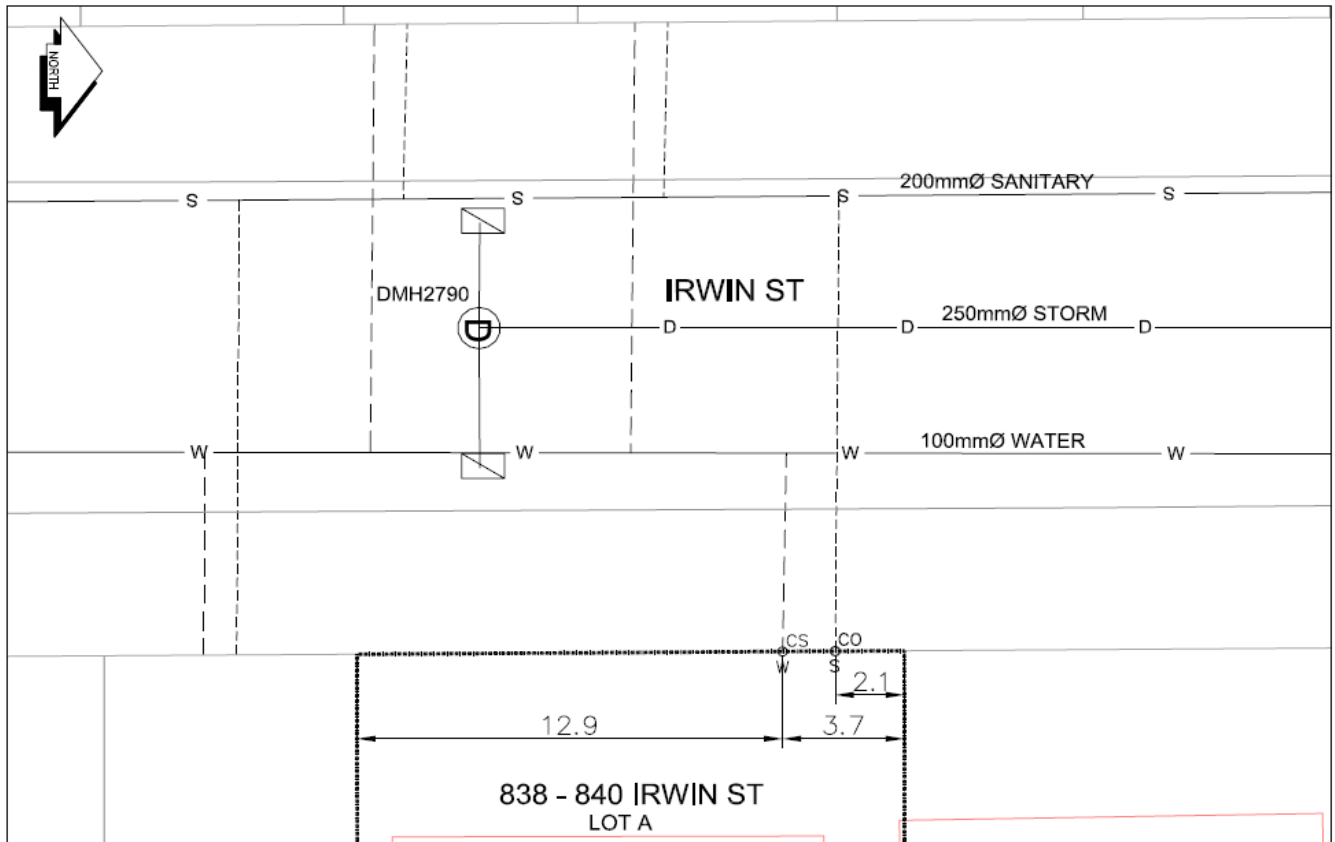

LEGEND:	CS ^o CURB STOP	--- WATER SERVICE	--- STORM SERVICE
	CO ^o CLEAN OUT	--- SANITARY SERVICE	WV WATER VALVE

NOT TO SCALE