

# City of Prince George HISTORY SHEET

SHEET NUMBER

Roll Number 010439587

Legal: LOT'S 84 BLOCK / D.L. 2608 PLAN 19520

Address: 288 BELLOS ST

Sanitary Connection: # 7375 SIZE 100mm MATERIAL A.C. INV. CONNECTED

Water Connection # 7375 SIZE 20mm MATERIAL C.V. METER CONNECTED

Storm Connection: # SIZE MATERIAL INV. CONNECTED

Cash Receipt No's: WATER SANITARY STORM

CURB FROM PROPERTY LINE 4.877m PAVEMENT WIDTH 10.363m

B.C. HYDRO U/G UNDERGROUND CONNECTION



B.C. TELEPHONE U/G UNDERGROUND CONNECTION

INLAND GAS AS SHOWN

Information Sheets:

Comments: WITH THAW WIRE;

THE INFORMATION CONTAINED HEREIN IS FOR INTERNAL USE ONLY.  
NOT TO BE RELIED UPON UNLESS CONFIRMED BY SITE INSPECTION AND/OR INVESTIGATION

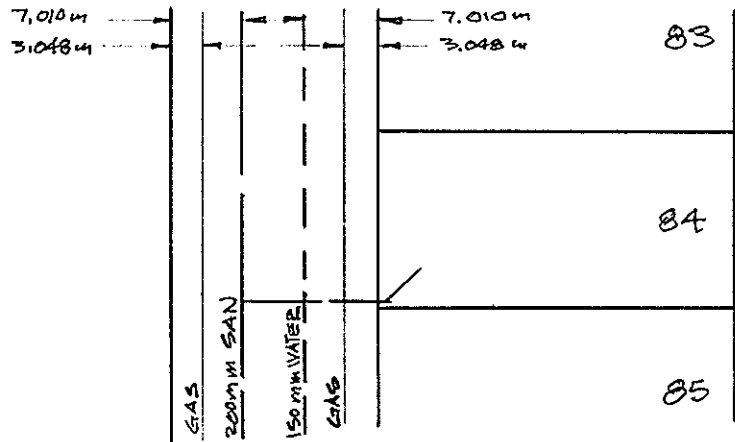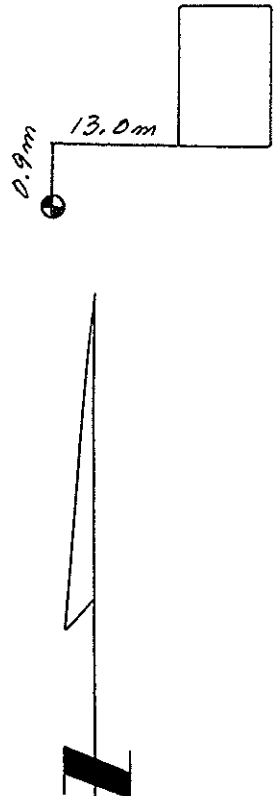

BELLOS ST.