

PID:	010440844
SD/MU:	
WO:	


Service Type	Diameter (mm)	Material	Invert Elev at main (m)	Invert Elev at property line (m)	Invert Elev at service end (m)	Distance into property (m)	Installation Date
Sanitary	100mm	PVC	-	-	-	-	December 1980
Water	20mm	Copper	610.95	611.70	-	-	August 2019
Storm	N/A	N/A	-	-	-	-	

Service Connection Location				Sanitary (m)	Storm (m)
Distance from downstream San MH	3790	towards upstream San MH	3774	48.47	
Distance from downstream Stm MH	-	towards upstream Stm MH	-		

Power	Size	Communications	Size	Cable	Size	Gas	Size
BC Hydro	-	Telus	-	Shaw	-	FortisBC	-
Underground Service		Underground Service		Underground Service			

Installed by:	Water service installed by City of Prince George forces	Survey Date:	-
Comments:			

NOT TO SCALE The information contained herein is for internal use only.
Not to be relied on unless confirmed by site inspection and/or investigation.

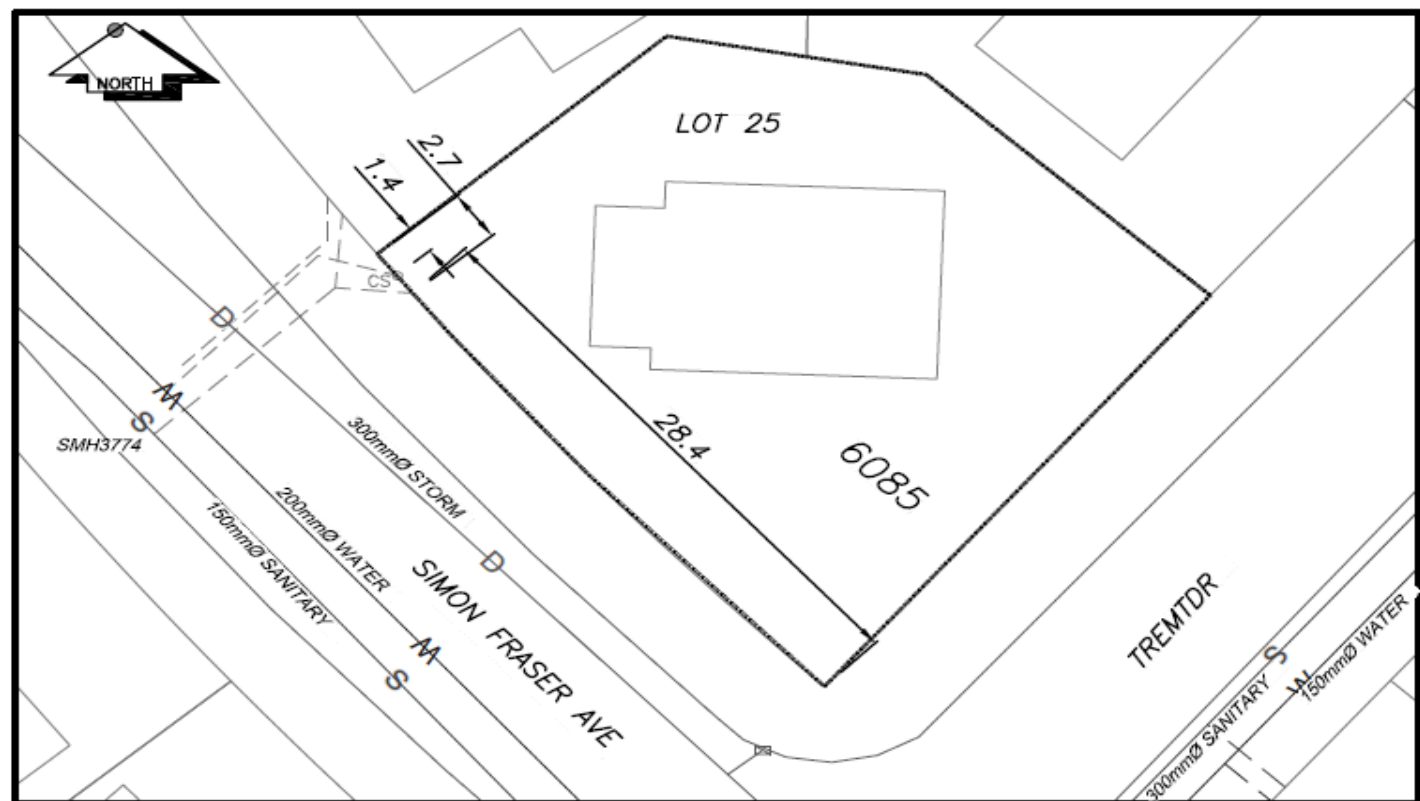

LEGEND:	CS ^o	CURB STOP		WATER SERVICE		STORM SERVICE
	CO ^o	CLEAN OUT		SANITARY SERVICE		GAS
		WATER VALVE		FIRE HYDRANT		ENCUMBRANCE

NOT TO SCALE