

City of Prince George HISTORY SHEET

010447725

SHEET NUMBER

Roll Number

Legal: LOT'S 21 BLOCK D.L. 913 PLAN 16511

Address: 152 AITKEN CRESCENT

Sanitary Connection: # 5677 SIZE 100mm MATERIAL INV. CONNECTED

Water Connection # 5677 SIZE MATERIAL METER CONNECTED

Storm Connection: # SIZE MATERIAL INV. CONNECTED

Cash Receipt No's: WATER SANITARY STORM

CURB FROM PROPERTY LINE PAVEMENT WIDTH

B.C. HYDRO UNDERGROUND CONNECTION


B.C. TELEPHONE UNDERGROUND CONNECTION

INLAND GAS

Information Sheets:

Comments: THE INFORMATION CONTAINED HEREIN IS FOR INTERNAL
USE ONLY. NOT TO BE RELIED UPON UNLESS CONFIRMED
BY SITE INSPECTION AND/OR INVESTIGATION.

SITE PLAN N.T.S.

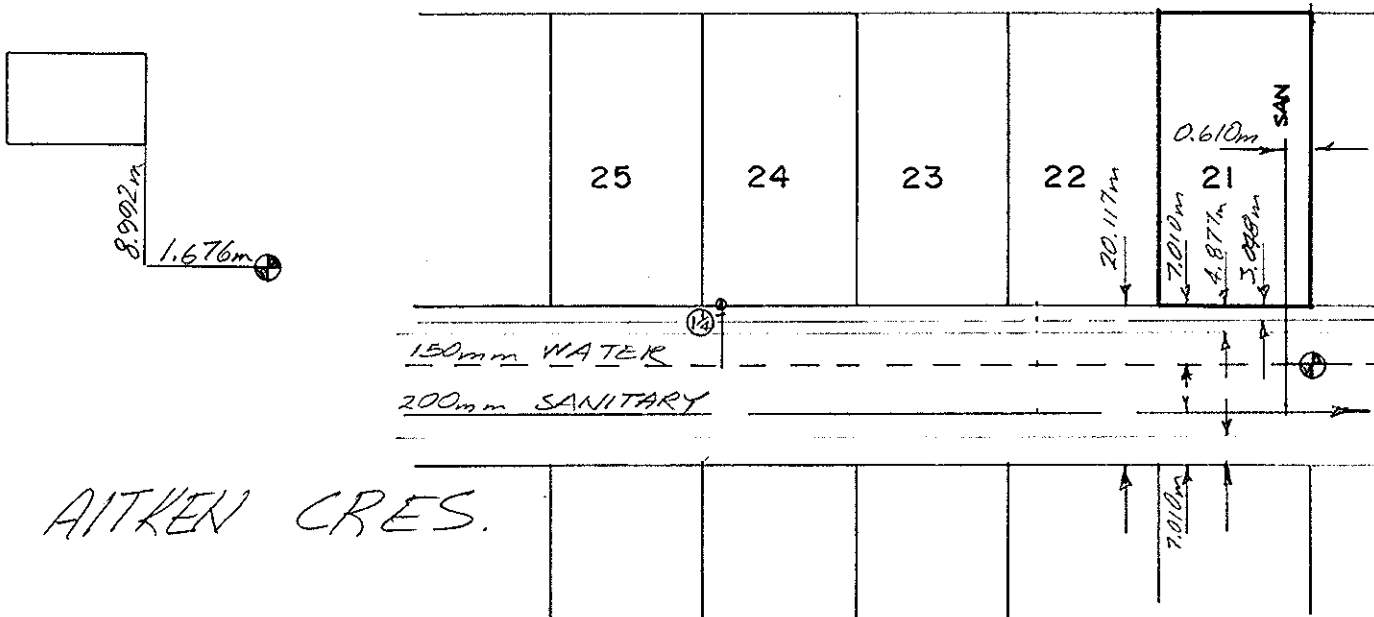

AITKEN CRES.