

# City of Prince George HISTORY SHEET

SHEET NUMBER

Roll Number 010482571

Legal: LOT'S 18 BLOCK — D.L. 2608 PLAN 19520

Address: 267 CLARK CRES

Sanitary Connection: # 7311 SIZE 100 mm MATERIAL AC INV. — CONNECTED

Water Connection # 7311 SIZE 20 mm MATERIAL COPPER METER — CONNECTED

Storm Connection: # — SIZE — MATERIAL — INV. — CONNECTED

Cash Receipt No's: WATER — SANITARY — STORM —

CURB FROM PROPERTY LINE 4.877 m PAVEMENT WIDTH 10.363 m

B.C. HYDRO U/G UNDERGROUND CONNECTION



B.C. TELEPHONE U/G UNDERGROUND CONNECTION

INLAND GAS AS SHOWN

Information Sheets:

Comments:

**THE INFORMATION CONTAINED HEREIN IS FOR INTERNAL USE ONLY.  
NOT TO BE RELIED UPON UNLESS CONFIRMED BY SITE INSPECTION AND/OR INVESTIGATION**

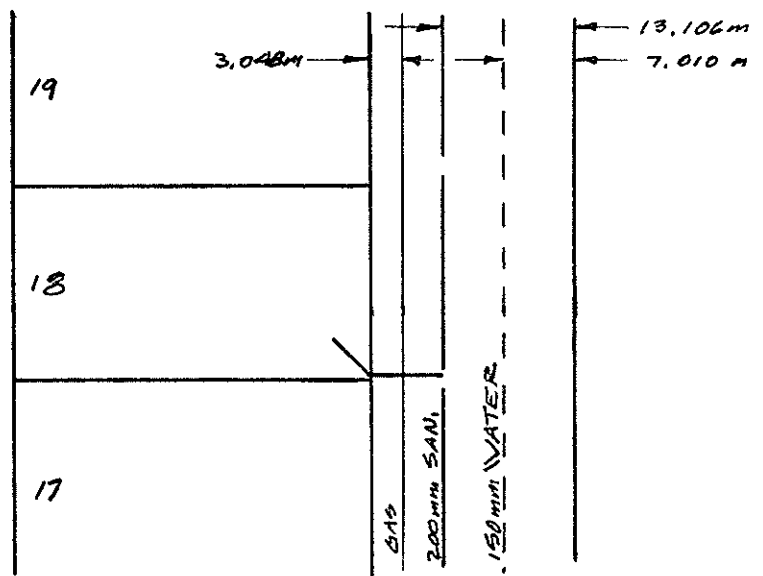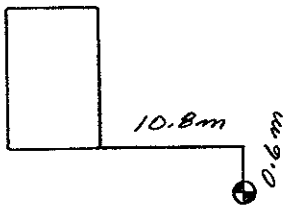

CLARK CRES.