



City of Prince George History Sheet

PID:	010485465
SD/MU:	
WO:	

Civic Address: 4356 1st Ave
4360 1st Ave
4364 1st Ave
4368 1st Ave

Legal Description: Lot: 58 District Lot: 2608 Plan: 19520


Service Type	Diameter (mm)	Material	Invert Elev at main (m)	Invert Elev at property line (m)	Invert Elev at service end (m)	Distance into property (m)	Installation Date
Sanitary	100mm	PVC	-	-	-	-	January 1971
Water	25mm	Copper	-	-	-	-	
Storm	N/A	N/A	-	-	-	-	

Service Connection Location					Sanitary (m)	Storm (m)
Distance from downstream San MH	2333	towards upstream San MH	2331		33.97	
Distance from downstream Stm MH	-	towards upstream Stm MH	-			

Power	Size	Communications	Size	Cable	Size	Gas	Size
BC Hydro	-	Telus	-	Shaw	-	FortisBC	-
Underground Service		Underground Service		Underground Service			

Installed by:	Survey Date:	-
Comments: Water service location confirmed September 2012 by John Handler.		

NOT TO SCALE The information contained herein is for internal use only.
Not to be relied on unless confirmed by site inspection and/or investigation.

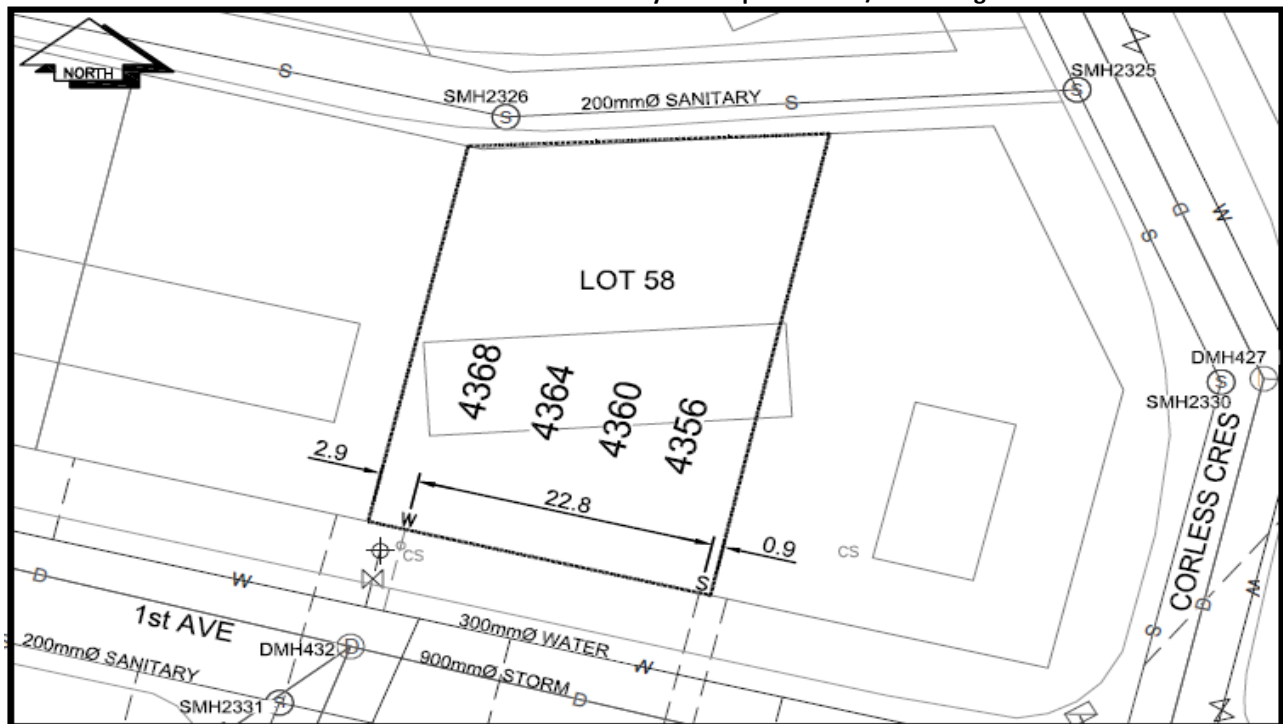

CS	CURB STOP	---	WATER SERVICE	---	STORM SERVICE
CO	CLEAN OUT	---	SANITARY SERVICE	---	GAS

NOT TO SCALE