



City of Prince George  
**History Sheet**

PID:	010485473
SD/MU:	
WO:	

Civic Address: 4348 - 4352 1st Ave

Legal Description: Lot: 59 District Lot: 2608 Plan: 19520


Service Type	Diameter (mm)	Material	Invert Elev at main (m)	Depth of cut at property line (m)	Invert Elev at service end (m)	Distance into property (m)	Installation Date
Sanitary	100mm	PVC	-	2.05	603.09	-	January 1971
Water	25mm	Copper	-	-	-	-	
Storm	N/A	N/A	-	-	-	-	

Service Connection Location				Sanitary (m)	Storm (m)
Distance from downstream San MH	2333	towards upstream San MH	2331	31.90	
Distance from downstream Stm MH	-	towards upstream Stm MH	-		

Power	Size	Communications	Size	Cable	Size	Gas	Size
BC Hydro	-	Telus	-	Shaw	-	FortisBC	-
Underground Service		Underground Service		Underground Service			

Installed by:	Survey Date:	-
Comments: City of Prince George forces confirmed location October 1, 2004		

**NOT TO SCALE** The information contained herein is for internal use only.  
Not to be relied on unless confirmed by site inspection and/or investigation.

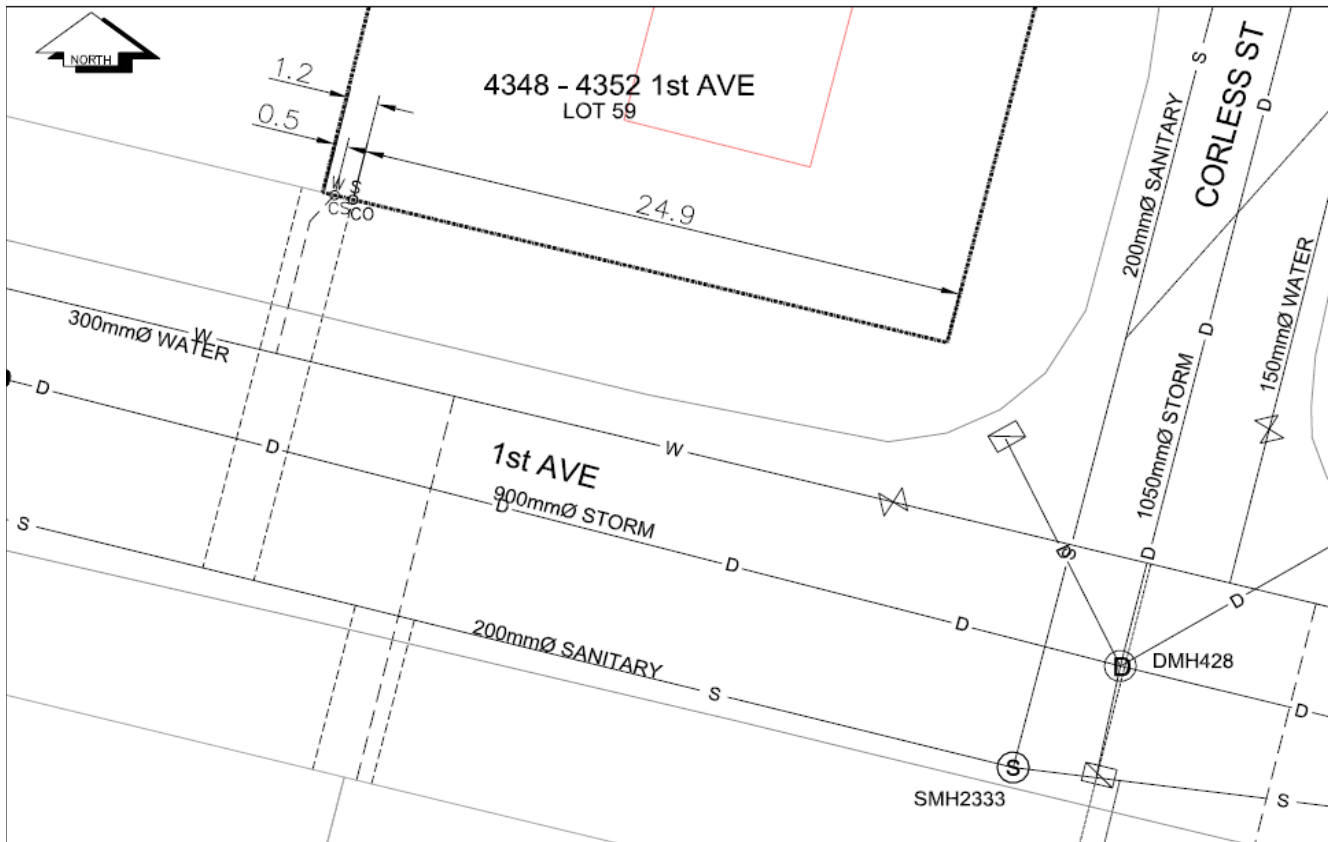

LEGEND:

CS CURB STOP  
CO CLEAN OUT

--- W WATER SERVICE  
--- S SANITARY SERVICE

--- D STORM SERVICE  
X WATER VALVE

**NOT TO SCALE**