



City of Prince George History Sheet

PID:	010489207
SD/MU:	
WO:	

Civic Address: 258 Fern Cres

Legal Description: Lot: 12 District Lot: 8178 Plan: 19441


Service Type	Diameter (mm)	Material	Invert Elev at main (m)	Invert Elev at property line (m)	Invert Depth at service end (m)	Invert Elev at property line (m)	Installation Date
Sanitary	100mm	AC	-	-	-	-	December 1965
Water	20mm	Copper	-	-	-	-	December 1965
Storm	N/A	N/A	-	-	-	-	

Service Connection Location	Sanitary (m)	Storm (m)
100mm Sanitary service connected to san MH2070	-	
Distance from downstream Stm MH - towards upstream Stm MH -		

Power	Size	Communications	Size	Cable	Size	Gas	Size
BC Hydro	-	Telus	-	Shaw	-	FortisBC	-
Underground Service		Underground Service		Underground Service			

Installed by:	Survey Date:	-
Comments: Water service location confirmed May 29, 2017		

NOT TO SCALE The information contained herein is for internal use only.
Not to be relied on unless confirmed by site inspection and/or investigation.

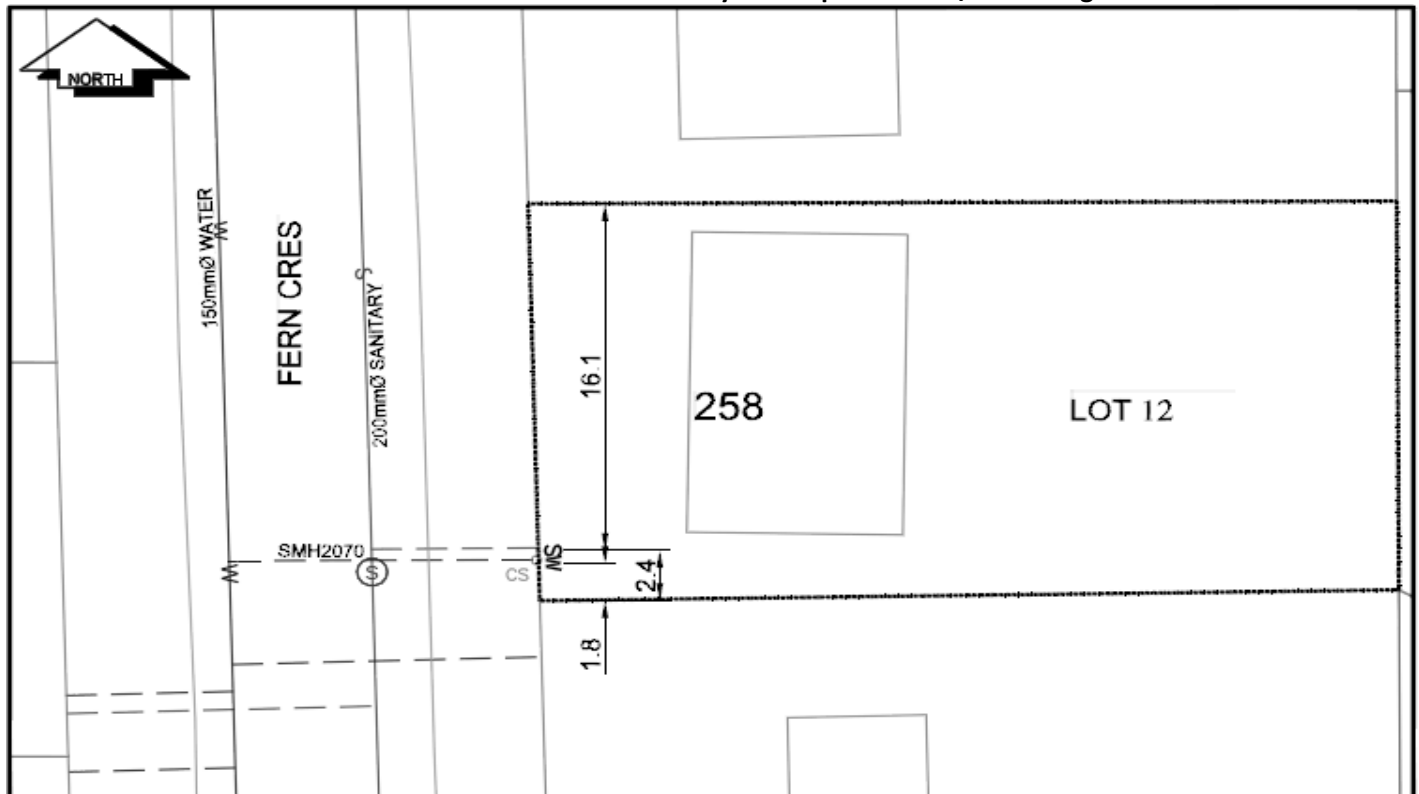

CS ^o CURB STOP	--- W WATER SERVICE	--- S STORM SERVICE
CO ^o CLEAN OUT	--- S SANITARY SERVICE	--- G GAS
⊗ WATER VALVE	⊗ FIRE HYDRANT	--- ENCUMBRANCE

NOT TO SCALE