



City of Prince George History Sheet

PID:	010600663
MU:	100786
WO:	40367/40368

Civic Address: 3907, 3963 15th Ave

Legal Description: Lot: 1 District Lot: 2508 Plan: 19210


Service Type	Diameter (mm)	Material	Invert Elev at main (m)	Invert Elev at property line (m)	Invert Elev at service end (m)	Distance into property (m)	Installation Date
Sanitary (S1)	100mm	PVC	-	-	-	-	May 2008
Water (W1)	50mm	Copper	-	-	-	-	May 2008
Storm (D1)	150mm	PVC	-	-	-	-	May 2008
Sanitary (S2)	100mm	AC	-	-	-	-	December 1985
Water (W2)	50mm	Copper	-	-	-	-	December 1967
Storm (D2)	150mm	AC	-	-	-	-	December 1965
Water (W3)	50mm	Copper	-	-	-	-	December 1963
Storm (D3)	150mm	AC	-	-	-	-	December 1985

Service Connection Location				Sanitary (m)	Storm (m)
Distance from downstream San MH		-	towards upstream San MH	-	
Distance from downstream Stm MH		-	towards upstream Stm MH	-	

Power	Size	Communications	Size	Cable	Size	Gas	Size
BC Hydro	-	Telus	-	Shaw	-	FortisBC	-
Underground Service		Underground Service		Underground Service			

Installed by:	City of Prince George forces	Survey Date:	-
Comments:			

NOT TO SCALE The information contained herein is for internal use only.
Not to be relied on unless confirmed by site inspection and/or investigation.

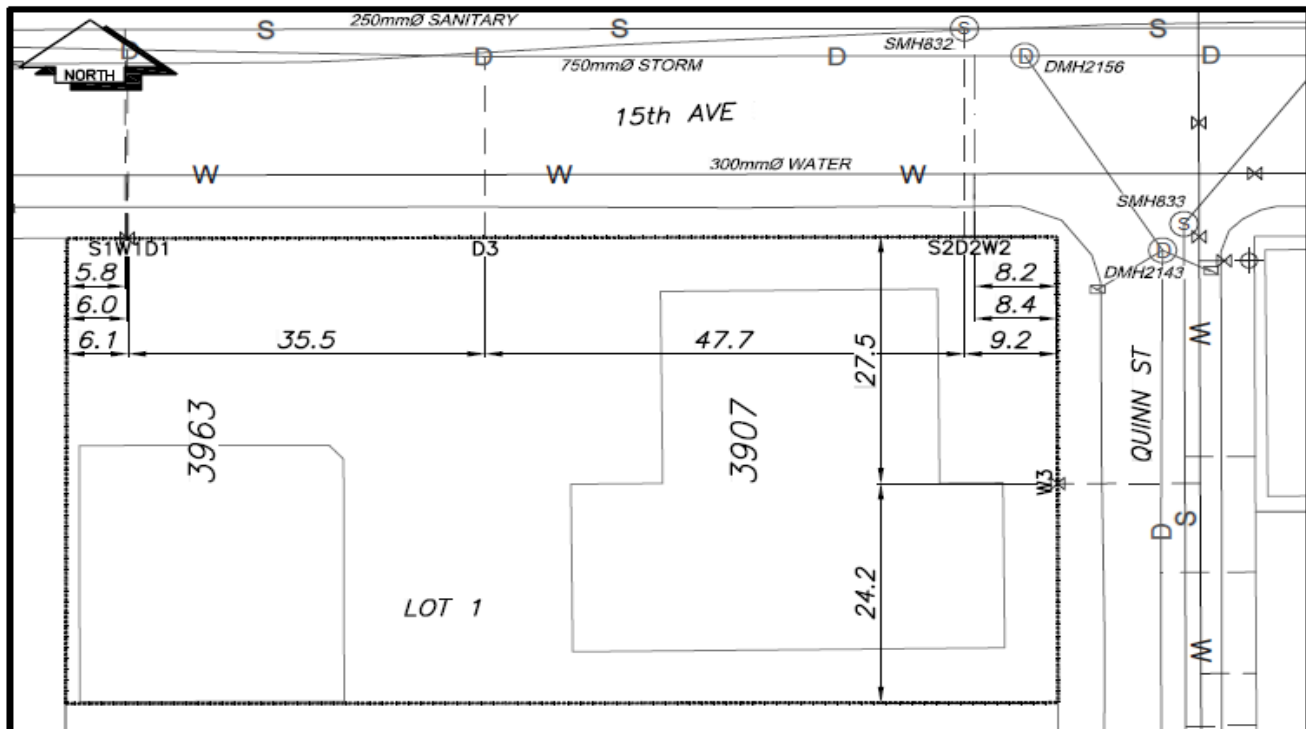

NOT TO SCALE