



City of Prince George History Sheet

PID:	010617540
SD/MU:	
WO:	

Civic Address: 4201 Davis Rd

Legal Description: Lot: 136 District Lot: 905 Plan: 24848


Service Type	Diameter (mm)	Material	Invert Elev at main (m)	Invert Elev at property line (m)	Invert Elev at service end (m)	Distance into property (m)	Installation Date
Sanitary	100mm	PVC	-	-	-	-	December 1977
Water	20mm	Copper	-	-	-	-	September 2017
Storm	100mm	PVC	-	-	-	-	December 1977

Service Connection Location				Sanitary (m)	Storm (m)
Distance from downstream San MH	3690	towards upstream San MH	3692	13.26	
Distance from downstream Stm MH	1826	towards upstream Stm MH	1850		17.53

Power	Size	Communications	Size	Cable	Size	Gas	Size
BC Hydro	-	Telus	-	Shaw	-	FortisBC	-
Overhead Service		Overhead Service		Overhead Service			

Installed by:	City of Prince George forces	Survey Date:	-
Comments:	New 20mm water service installed in September 2017		

NOT TO SCALE The information contained herein is for internal use only.
Not to be relied on unless confirmed by site inspection and/or investigation.

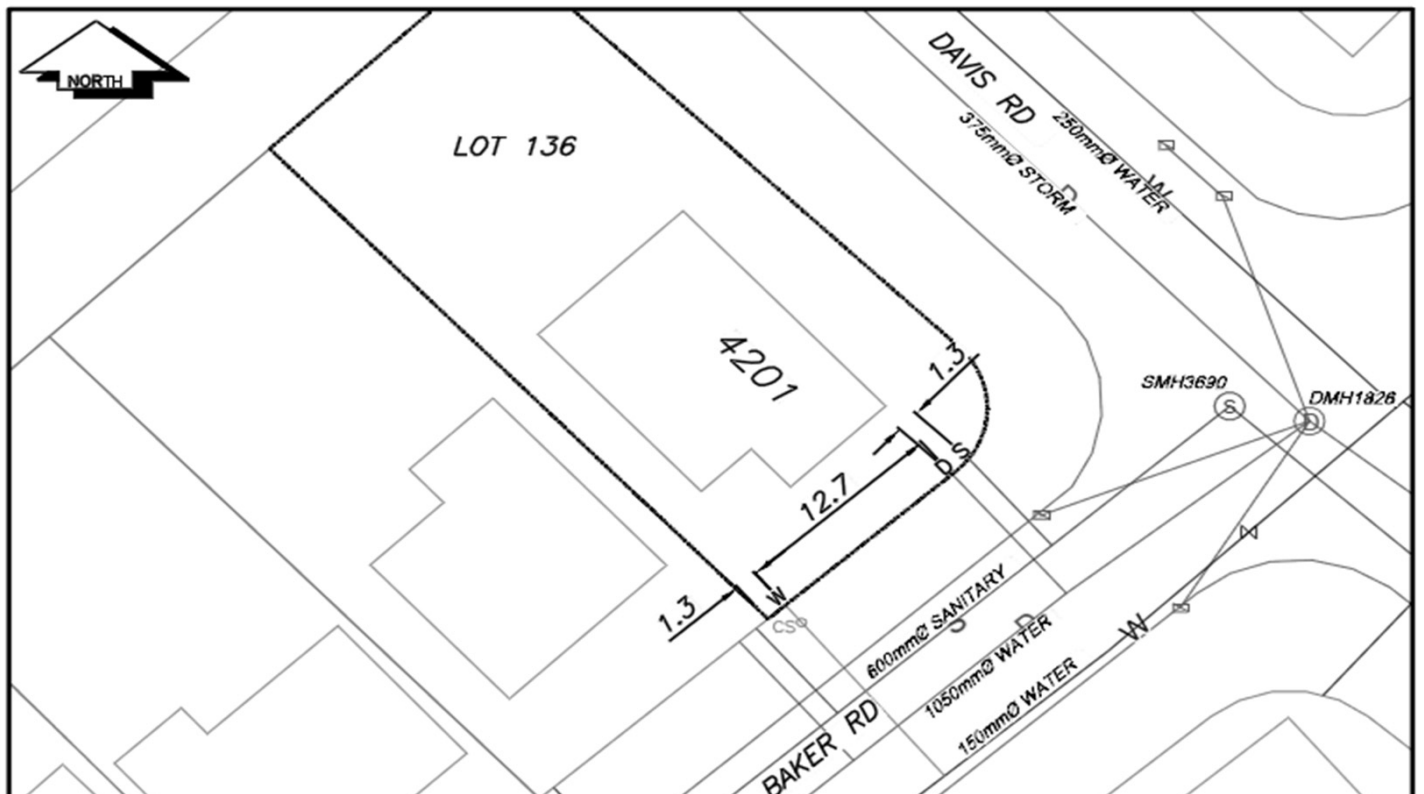

CS	CURB STOP	W	WATER SERVICE	S	SANITARY SERVICE	W	STORM SERVICE
CO	CLEAN OUT	- - -		- - -		G	GAS
WV	WATER VALVE	FH	FIRE HYDRANT	- - -		- - -	ENCUMBRANCE

NOT TO SCALE