



City of Prince George History Sheet

PID:	010743812
SD/MU:	
WO:	

Civic Address: 2222 Blackburn Rd

Legal Description: Lot: A District Lot: 1543 Plan: 18816


Service Type	Diameter (mm)	Material	Invert Elev at main (m)	Invert Elev at property line (m)	Invert Elev at service end (m)	Distance into property (m)	Installation Date
Sanitary	100mm	AC	-	-	-	-	January 1976
Water - north	150mm	AC	-	-	-	-	January 1970
Water - east	150mm	AC	-	-	-	-	January 1970
Storm	N/A	N/A	-	-	-	-	

Service Connection Location				Sanitary (m)	Storm (m)
Distance from downstream San MH	1131	towards upstream San MH	1130	33.81	
Distance from downstream Stm MH	-	towards upstream Stm MH	-	-	

Power	Size	Communications	Size	Cable	Size	Gas	Size
BC Hydro	-	Telus	-	Shaw	-	FortisBC	-
Overhead Service		Overhead Service		Overhead Service			

Installed by:	Survey Date:	-
Comments: Anitarity service location assumed to be 100mm as no big connections to manholes.		

NOT TO SCALE The information contained herein is for internal use only.
Not to be relied on unless confirmed by site inspection and/or investigation.

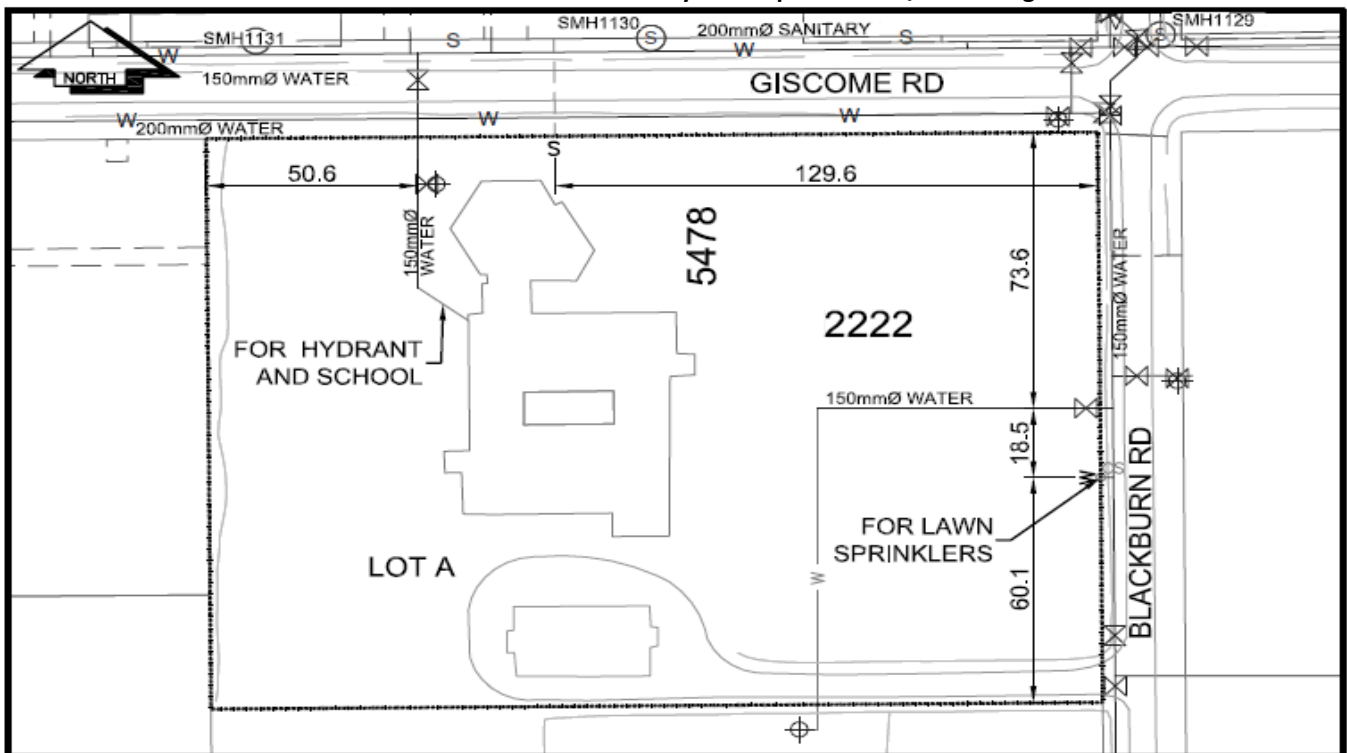

LEGEND:	CS CURB STOP	--- WATER SERVICE	--- STORM SERVICE
	CO CLEAN OUT	--- SANITARY SERVICE	--- G GAS

NOT TO SCALE