



City of Prince George History Sheet

| | |
|--------|-----------|
| PID: | 010769048 |
| SD/MU: | |
| WO: | |

Civic Address: 3803 Alderwood Court
Legal Description: Lot: B District Lot: 4040 Plan: 18926


| Service Type | Diameter (mm) | Material | Invert Elev at main (m) | Invert Elev at property line (m) | Invert Depth at service end (m) | Distance into property (m) | Installation Date |
|--------------|---------------|----------|-------------------------|----------------------------------|---------------------------------|----------------------------|-------------------|
| Sanitary | 100mm | AC | - | 648.29 | 3.04 | - | January 1978 |
| Water | 20mm | Copper | - | - | - | - | January 1972 |
| Storm | N/A | N/A | - | - | - | - | |

| Service Connection Location | | | | Sanitary (m) | Storm (m) |
|---------------------------------|------|-------------------------|------|--------------|-----------|
| Distance from downstream San MH | 1396 | towards upstream San MH | 1405 | 43.00 | |
| Distance from downstream Stm MH | - | towards upstream Stm MH | - | | |

| Power | Size | Communications | Size | Cable | Size | Gas | Size |
|------------------|------|------------------|------|------------------|------|----------|------|
| BC Hydro | - | Telus | - | Shaw | - | FortisBC | - |
| Overhead Service | | Overhead Service | | Overhead Service | | | |

| | | |
|---------------|---|---|
| Installed by: | Survey Date: | - |
| Comments: | Water service location as per April 11, 2017 locate | |
| | | |
| | | |

NOT TO SCALE The information contained herein is for internal use only.
Not to be relied on unless confirmed by site inspection and/or investigation.

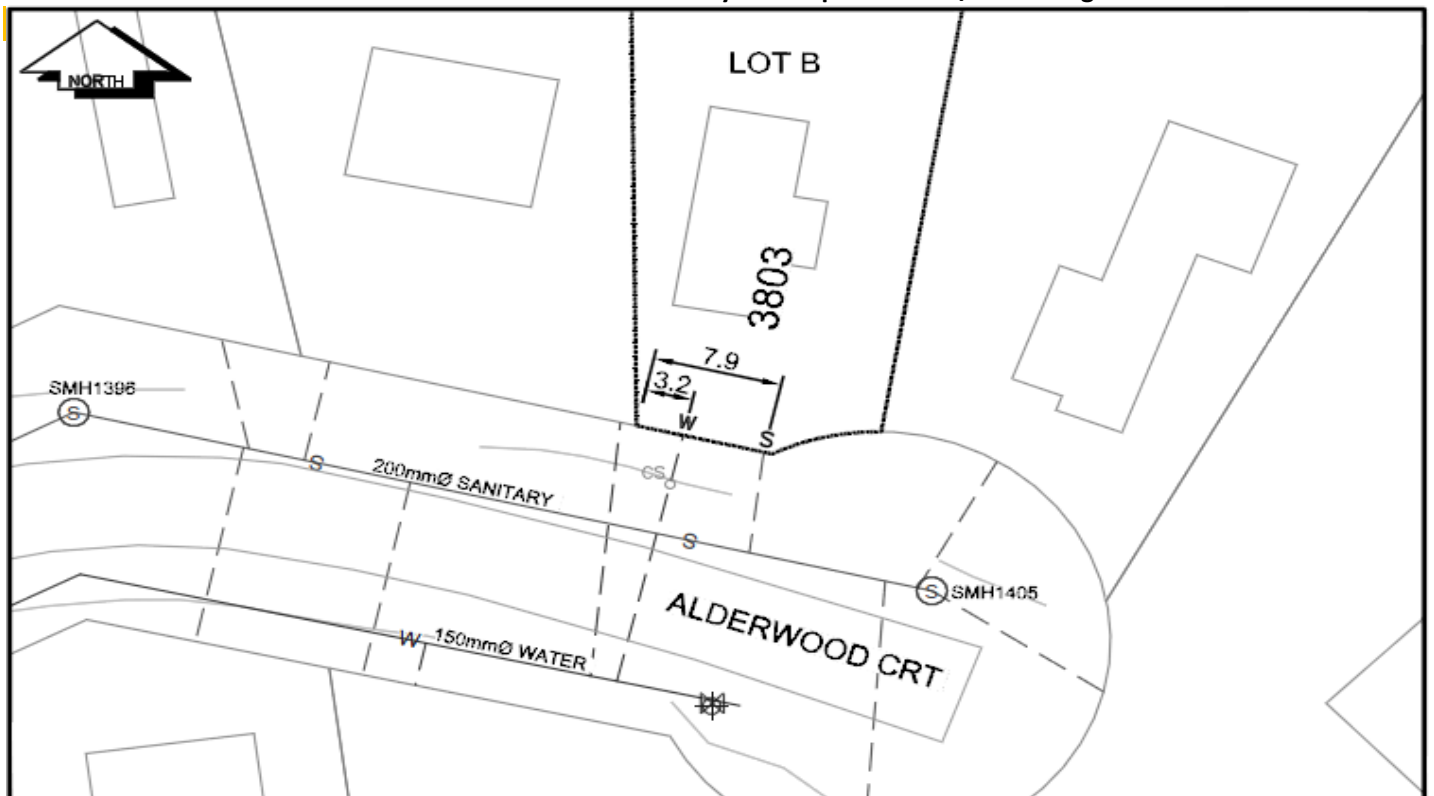

| | | |
|---------------|----------------------|-------------------|
| CS CURB STOP | --- WATER SERVICE | --- STORM SERVICE |
| CO CLEAN OUT | --- SANITARY SERVICE | --- GAS |
| ⊗ WATER VALVE | ⊗ FIRE HYDRANT | --- ENCUMBRANCE |

NOT TO SCALE