



City of Prince George History Sheet

PID:	010830014
SD/MU:	
WO:	

Civic Address: 1100 Alward St

Legal Description: Lot: 1 District Lot: 343 Plan: 18364


Service Type	Diameter (mm)	Material	Invert Elev at main (m)	Invert Elev at property line (m)	Invert Elev at service end (m)	Distance into property (m)	Installation Date
Sanitary	150mm	PVC	-	585.02	-	-	May 2014
Sanitary	150mm	PVC	-	585.00	-	-	May 2014
Water	150mm	PVC	-	585.48	-	-	May 2014
Storm	300mm	PVC	-	585.48	-	-	May 2014

Service Connection Location				Sanitary (m)	Storm (m)
Distance from downstream San MH	2837	towards upstream San MH	3081	47.8, 82.9	
Distance from downstream Stm MH	3822	towards upstream Stm MH	3822		0.00

Power	Size	Communications	Size	Cable	Size	Gas	Size
BC Hydro	-	Telus	-	Shaw	-	FortisBC	-
Underground Service		Underground Service		Underground Service			

Installed by:	City of Prince George	Survey Date:	-
Comments:	See also eDoc 289303		

NOT TO SCALE The information contained herein is for internal use only.
Not to be relied on unless confirmed by site inspection and/or investigation.

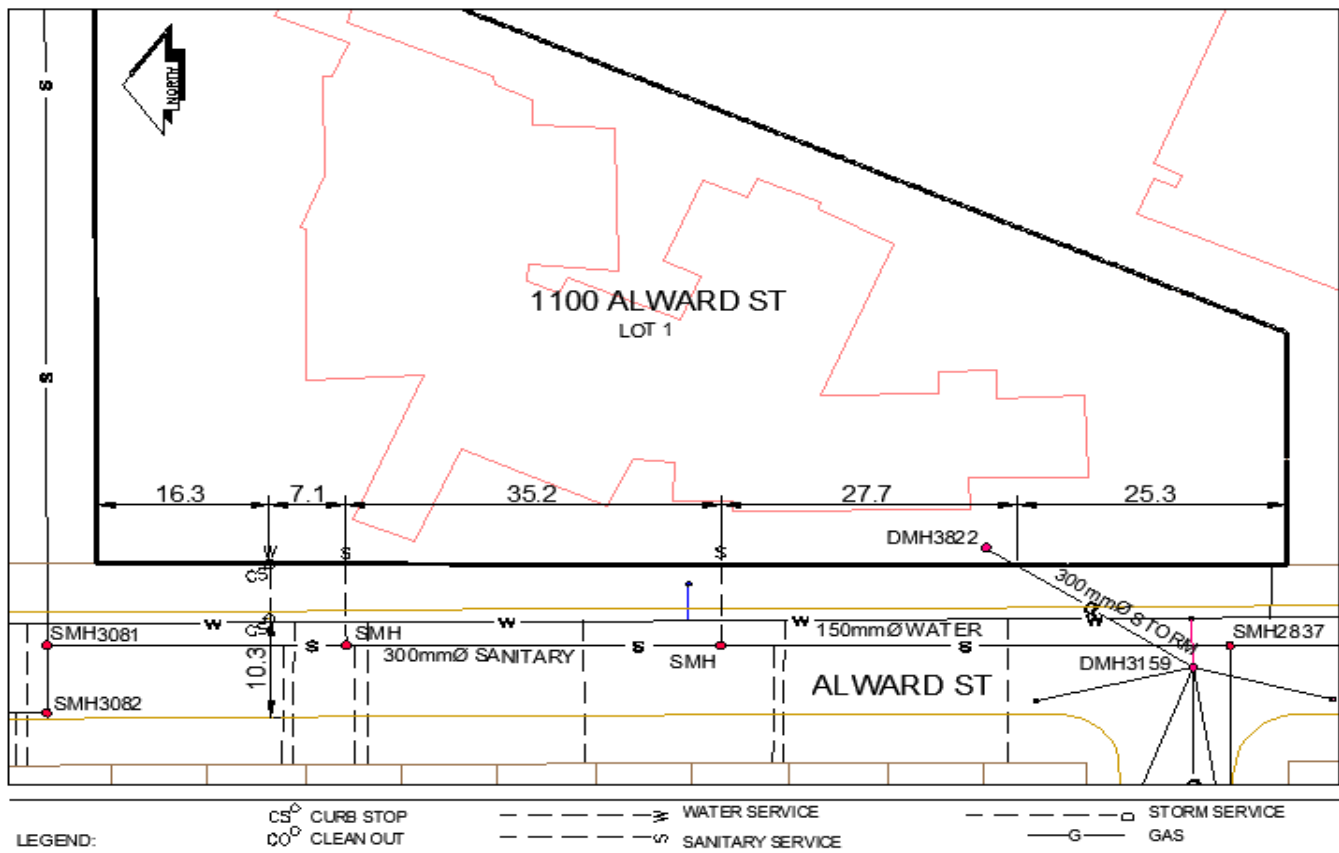

NOT TO SCALE