

010881212

**Roll Number**

Address: 7138 GLENVIEW DRIVE

Water Connection #	SIZE	MATERIAL	METER	CONNECTED
	3/4			

Storm Connection:	#	SIZE	MATERIAL	INV.	CONNECTED
-------------------	---	------	----------	------	-----------

Cash Receipt No's:	WATER	SANITARY	STORM
--------------------	-------	----------	-------

CURB FROM PROPERTY LINE PAVEMENT WIDTH

B.C. HYDRO UNDERGROUND CONNECTION

B.C. TELEPHONE	UNDERGROUND CONNECTION
----------------	------------------------

## INLAND GAS


**Information Sheets:**

Comments: 110' WATER SERVICE - 20' NORTH OF SOUTH H

OWNER: ORR ROBERT BLAIR & RETA MARIE 1-7-75

**GROUND CONNECTION**

The information contained herein is for internal use only. Not to be relied upon unless confirmed by site inspection and/or investigation.

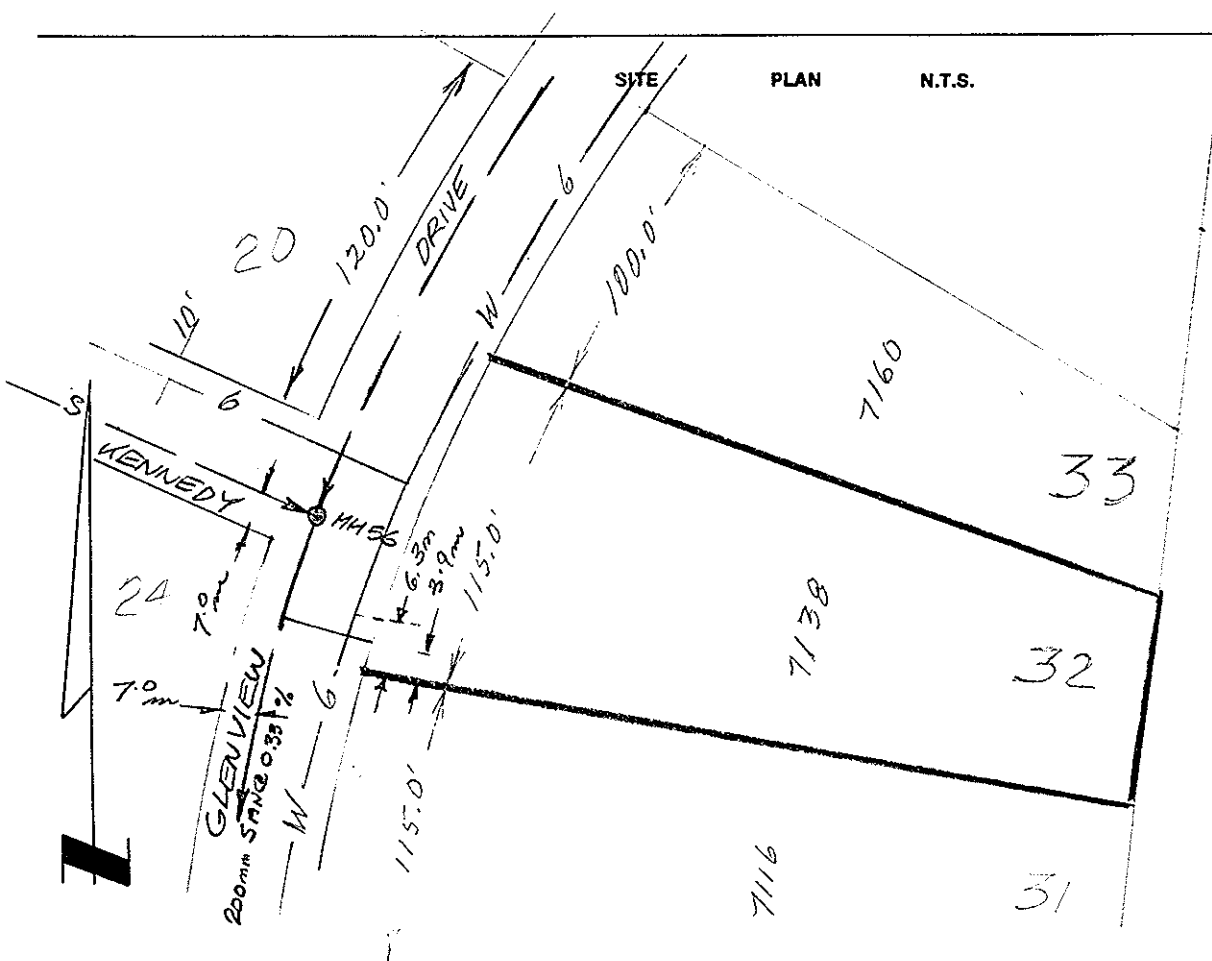

# SANITARY & STORM INVERT CALCULATIONS

SANITARY

STORM

1. Distance from M.H. 55 to connection point is 50.0 m ft. toward M.H. 56
2. Calculated invert of main to conn. pt. is \_\_\_\_\_
3. Main Size at connection point is \_\_\_\_\_ ins.
4. Conn. invert at half diameter (Crown) of main is \_\_\_\_\_
5. Add to (4) allowance of 0.2 for 1/8 bend. Adjusted invert now \_\_\_\_\_
6. Dist. from main to P/L equals \_\_\_\_\_ ft. at \_\_\_\_\_ in/ft. gives rise of \_\_\_\_\_
7. Item (5) plus (6) equals Calculated Elev. of conn. inv. at P/L equals \_\_\_\_\_
13. Elev. of ref. hub top GROUND
14. Elev. of invert at P/line \_\_\_\_\_
15. Difference or cut below at property line \_\_\_\_\_
16. Survey Date \_\_\_\_\_ 19 \_\_\_\_\_ Book Ref. \_\_\_\_\_ by \_\_\_\_\_
17. Cut at P/Line in feet and inches \_\_\_\_\_

32.2  
30.1  
7'

## Sanitary History:

Water History: Dec 29/82 Loc by L. Parfitt

## Storm History: