

City of Prince George

HISTORY SHEET

PID: 010901973

Scale: 1:1000

Legal: 6

D.L.: 2424

PLAN: 10807

Address: 4758 CHIEF LAKE ROAD

Sanitary Connection: 16660 SIZE: 100mmØ MATERIAL: PVC INV. 753.61m CONNECTED

Water Connection: SIZE: 19mmØ MATERIAL: COPPER INV. 753.78m CONNECTED

Storm Connection: SIZE MATERIAL INV.

Cash Receipt No's: WATER SANITARY STORM

CURB FROM PROPERTY LINE PAVEMENT WIDTH

HYDRO O/H CONNECTION


TELEPHONE O/H CONNECTION

GAS

Information Sheets:

Comments: CS CURB STOP CO CLEAN OUT WATER SERVICE SANITARY SERVICE GAS E GAS ELECTRICAL

THE INFORMATION CONTAINED HEREIN IS FOR INTERNAL USE ONLY.
NOT TO BE RELIED UPON UNLESS CONFIRMED BY THE SITE INSPECTION AND/OR INVESTIGATION

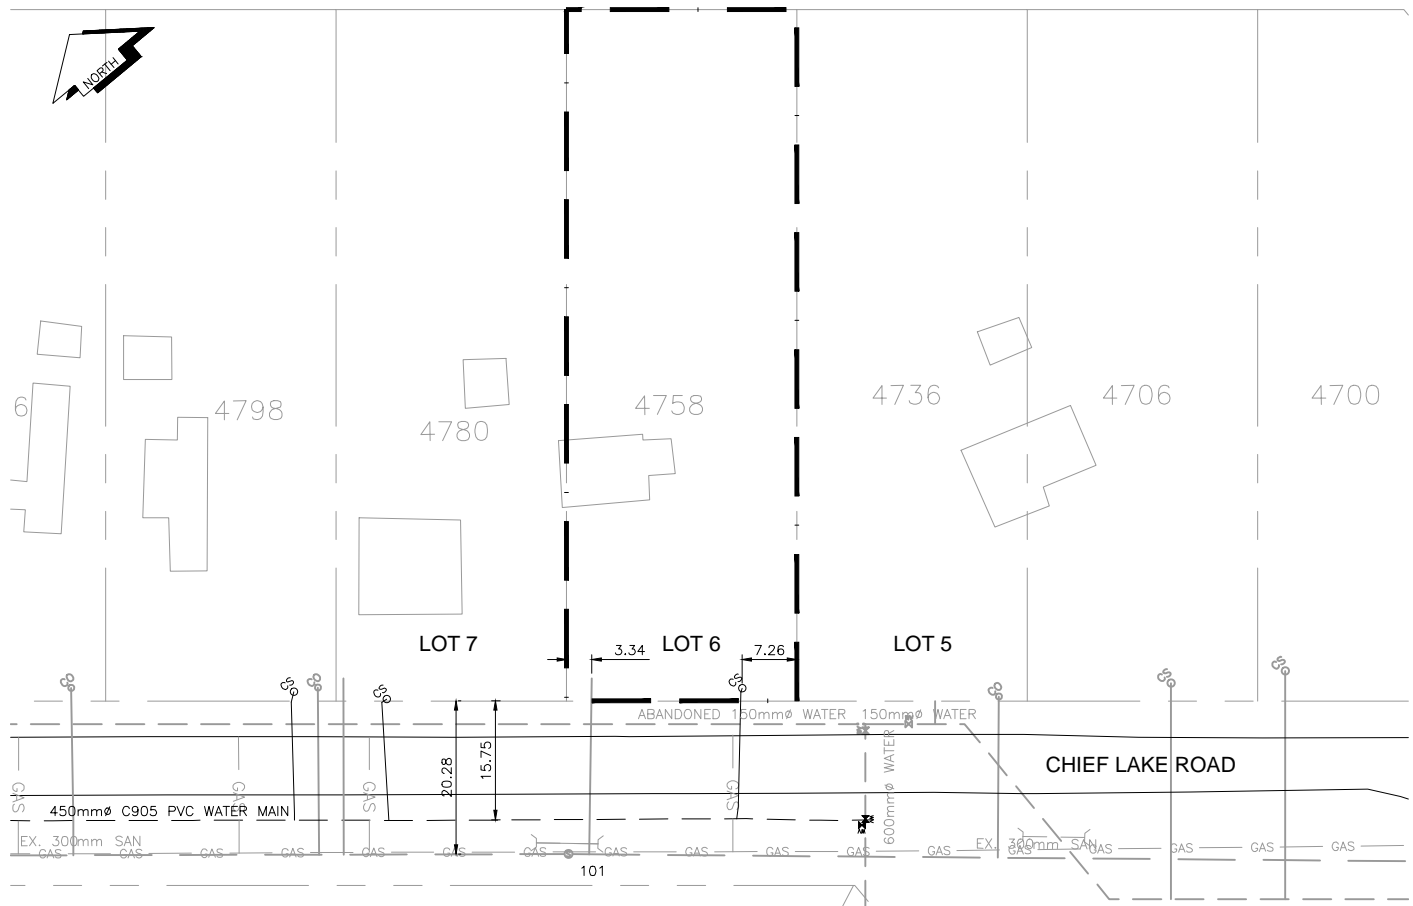

SANITARY, STORM & WATER SERVICE INVERTS	SANITARY	WATER	STORM
1. Distance from San. M.H. <u> 111 </u> toward San. M.H. <u> 101 </u> to lot service connection point is:	121.09m	101.50m	
2. Main Size at connection point is	100mmØ	19mmØ	
3. Obvert of main at conn. stub point is	753.08m	753.90m	
4. Obvert at service end is		753.80m	
5. Cover at property line in meters			
6. Survey Date:NOV 2014 Book Ref.:1035-55 By:L&M			

SANITARY HISTORY:

DATE INSTALLED: -

INSTALLED BY: -

NO SANITARY CLEAN OUT LOCATED ON LOT 6

WATER HISTORY:

DATE INSTALLED: SEPT 2014

INSTALLED BY: CoPG

STORM HISTORY:

DATE INSTALLED:

INSTALLED BY: