



City of Prince George History Sheet

PID:	011099739
MU:	102271
WO:	103686-103687

Civic Address: 7452, 7454 Irene Rd

Legal Description: Lot: 21 District Lot: 1599 Plan: 11601


Service Type	Diameter (mm)	Material	Invert Elev at main (m)	Invert Elev at property line (m)	Invert Elev at service end (m)	Distance into property (m)	Installation Date
Sanitary (S1)	100mm	PVC	-	-	-	-	January 1983
Sanitary (S2)	100mm	PVC	749.18	750.27	750.30	2.00	September 2020
Water (W1)	20mm	Copper	-	-	-	-	January 1978
Water (W2)	20mm	Copper	749.80	750.11	750.13	2.00	September 2020
Storm	N/A	N/A	-	-	-	-	

Service Connection Location				Sanitary (m)	Storm (m)
Distance from downstream San MH	4517	towards upstream San MH	4448	63.43	
Distance from downstream Stm MH	4517	towards upstream Stm MH	4448	82.01	

Power	Size	Communications	Size	Cable	Size	Gas	Size
BC Hydro	-	Telus	-	Shaw	-	FortisBC	-
Overhead Service		Overhead Service		Overhead Service			

Installed by:	Sanitary service (S2) & Water service (W2) installed by City of Prince George forces	Survey Date:	-
Comments:			

NOT TO SCALE The information contained herein is for internal use only.
Not to be relied on unless confirmed by site inspection and/or investigation.

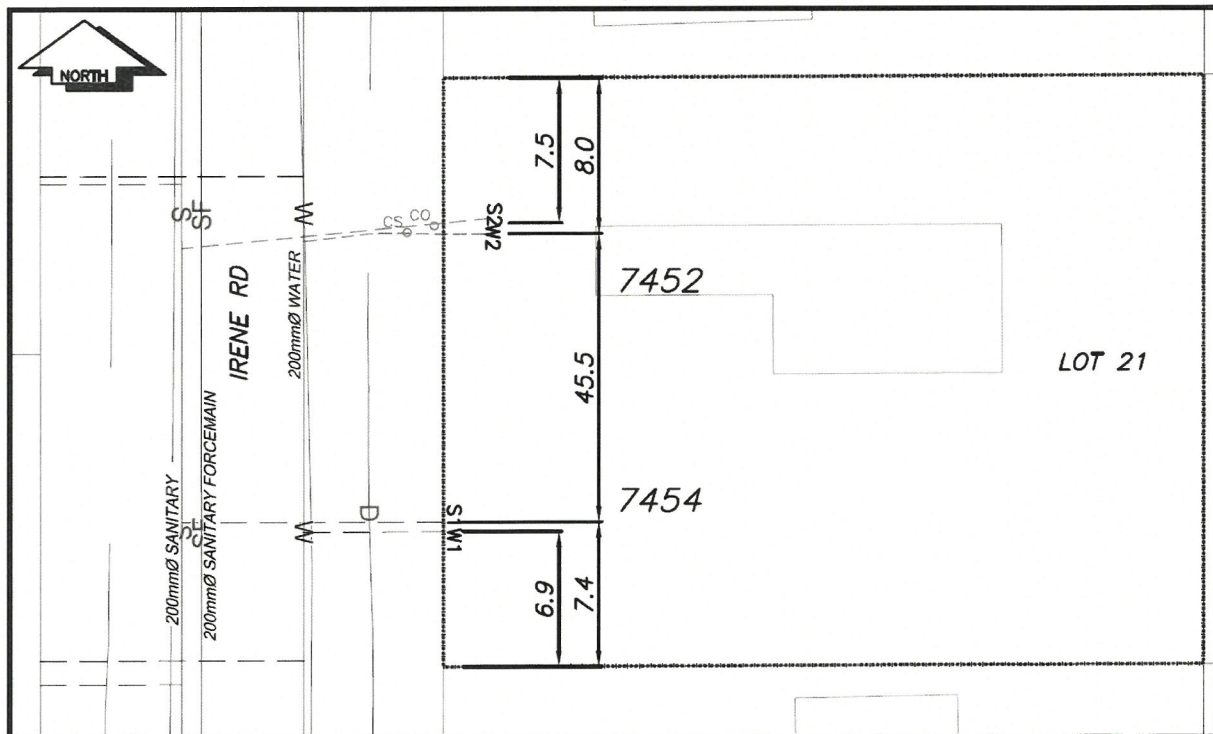

CS ^o	CURB STOP	—W—	WATER SERVICE	—S—	SANITARY SERVICE	—G—	GAS
CO ^o	CLEAN OUT	—S—	SANITARY SERVICE	—G—	GAS	—E—	ENCUMBERANCE
⊗	WATER VALVE	⊗	FIRE HYDRANT				

NOT TO SCALE