



City of Prince George History Sheet

| | |
|--------|-----------|
| PID: | 011100648 |
| SD/MU: | |
| WO: | |

Civic Address: 2720, 2722 Fairview Cres
Legal Description: Lot: 29 District Lot: 8175 Plan: 16074


| Service Type | Diameter (mm) | Material | Invert Elev at main (m) | Invert Elev at property line (m) | Invert Elev at service end (m) | Distance into property (m) | Installation Date |
|--------------|---------------|----------|-------------------------|----------------------------------|--------------------------------|----------------------------|-------------------|
| Sanitary | 100mm | AC | - | 588.66 | - | - | January 1966 |
| Water | 20mm | Copper | - | - | - | - | January 1966 |
| Storm | N/A | N/A | - | - | - | - | |

| Service Connection Location | | | | | Sanitary (m) | Storm (m) |
|---------------------------------|------|-------------------------|---|---|--------------|-----------|
| Distance from downstream San MH | 3840 | towards upstream San MH | - | - | - | |
| Distance from downstream Stm MH | - | towards upstream Stm MH | - | - | | |

| Power | Size | Communications | Size | Cable | Size | Gas | Size |
|---------------------|------|---------------------|------|---------------------|------|----------|------|
| BC Hydro | - | Telus | - | Shaw | - | FortisBC | - |
| Underground Service | | Underground Service | | Underground Service | | | |

| | | | |
|---------------|------------------------------|--------------|---|
| Installed by: | City of Prince George forces | Survey Date: | - |
| Comments: | | | |
| | | | |
| | | | |

NOT TO SCALE The information contained herein is for internal use only.
Not to be relied on unless confirmed by site inspection and/or investigation.

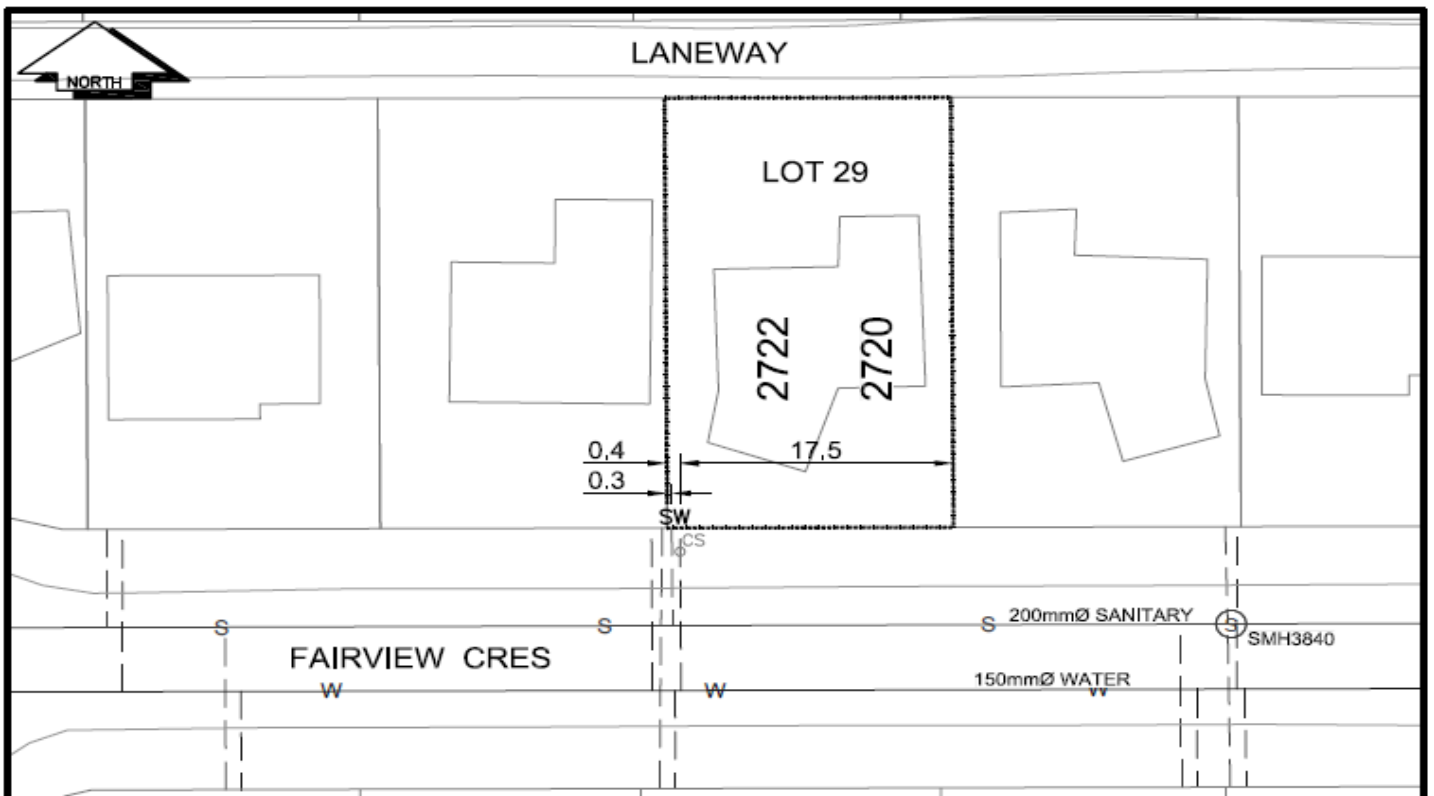

| | | |
|---------------------------|----------------------|-------------------|
| CS ^o CURB STOP | --- WATER SERVICE | --- STORM SERVICE |
| CO ^o CLEAN OUT | --- SANITARY SERVICE | --- GAS |
| ⊗ WATER VALVE | ⊗ FIRE HYDRANT | --- ENCUMBRANCE |

NOT TO SCALE