



City of Prince George History Sheet

PID:	011118997
MU:	101534
WO:	79169/81343

Civic Address: 5201 Chief Lake Rd

Legal Description: Lot: A District Lot: 2424 Plan: 18248


Service Type	Diameter (mm)	Material	Invert Elev at main (m)	Invert Elev at property line (m)	Invert Elev at service end (m)	Distance into property (m)	Installation Date
Sanitary	100mm	PVC	762.10	762.23	762.50	13.20	October 2015
Water	20mm	Copper	762.08	762.24	762.56	13.20	October 2014
Storm	N/A	N/A	-	-	-	-	

Service Connection Location				Sanitary (m)	Storm (m)
Distance from downstream San MH	85	towards upstream San MH	81	103.70	
Distance from downstream Stm MH	-	towards upstream Stm MH	-		

Power	Size	Communications	Size	Cable	Size	Gas	Size
BC Hydro	-	Telus	-	Shaw	-	FortisBC	-
Overhead Service		Overhead Service		Overhead Service			

Installed by:	City of Prince George forces	Survey Date:	-
Comments:			

NOT TO SCALE The information contained herein is for internal use only.
Not to be relied on unless confirmed by site inspection and/or investigation.

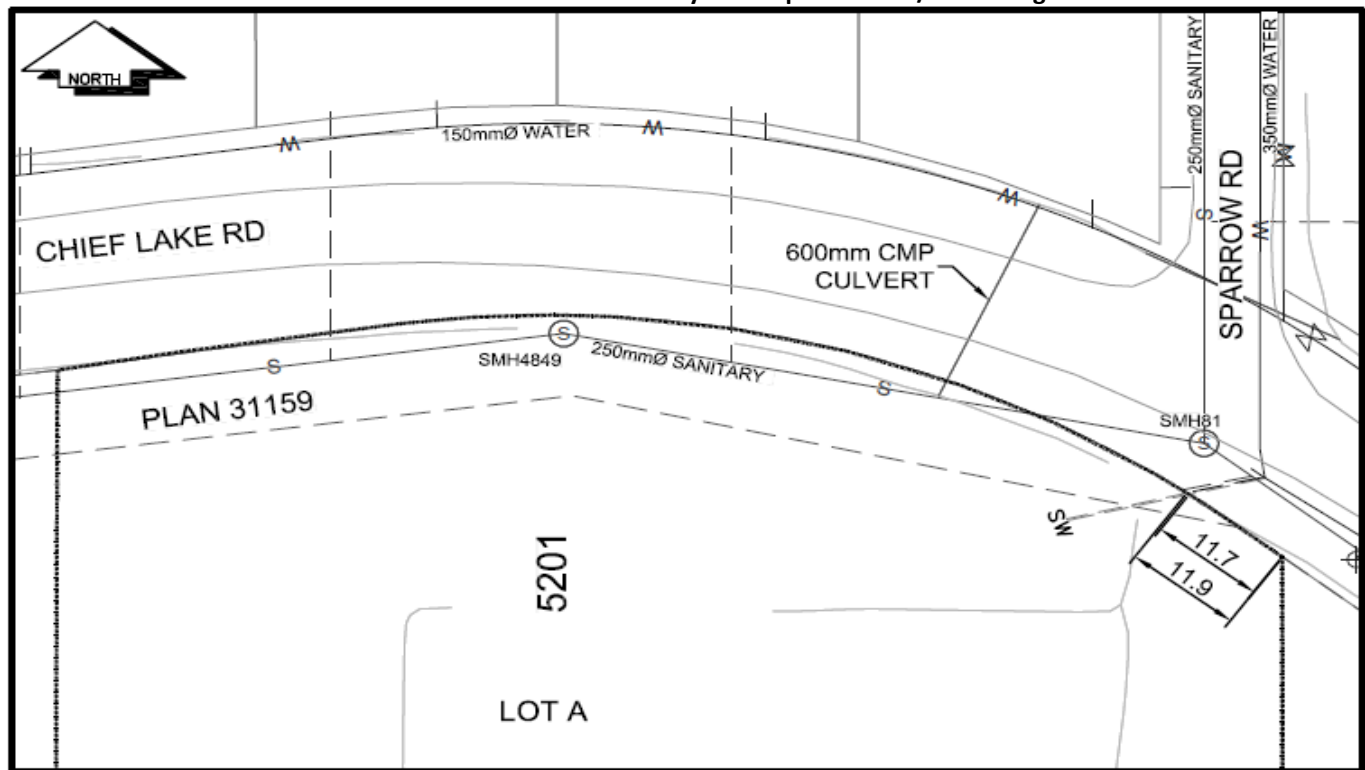

CS	CURB STOP	---	WATER SERVICE	---	STORM SERVICE
CO	CLEAN OUT	---	SANITARY SERVICE	---	GAS
WV	WATER VALVE	---	FIRE HYDRANT	---	ENCUMBRANCE

NOT TO SCALE