



City of Prince George  
**History Sheet**

PID:	014258081
	011164298
MU:	101307
WO:	65403

Civic Address: 4141, 4175, 4199 18th Ave  
2181, 2187 Ospika Blvd

Legal Description: Lot: PCL 1 District Lot: 2508 Plan: 33840

Legal Description: Lot: REM 1 & DL 2611 District Lot: 2508 Plan: 9467

Service Type	Diameter (mm)	Material	Invert Elev at main (m)	Invert Elev at property line (m)	Invert Elev at service end (m)	Distance into property (m)	Installation Date
Sanitary	200mm	AC	-	-	-	-	January 1972
Water - W1	200mm	AC	-	-	-	-	January 1994
Water - W2	150mm	PVC	-	-	-	-	June 2012
Water - W3	150mm	PVC	-	-	-	-	June 2012
Water - W4	150mm	AC	-	-	-	-	January 1979
Storm	450mm	Concrete	-	-	-	-	January 1972


Service Connection Location	Sanitary (m)	Storm (m)
Distance from downstream San MH - towards upstream San MH	-	
Distance from downstream Stm MH - towards upstream Stm MH	-	

Power	Size	Communications	Size	Cable	Size	Gas	Size
BC Hydro	-	Telus	-	Shaw	-	FortisBC	-
Underground Service		Underground Service		Underground Service			

Installed by:	Survey Date:	-
Comments:		

**NOT TO SCALE** The information contained herein is for internal use only.  
**Not to be relied on unless confirmed by site inspection and/or investigation.**

**NOT TO SCALE**

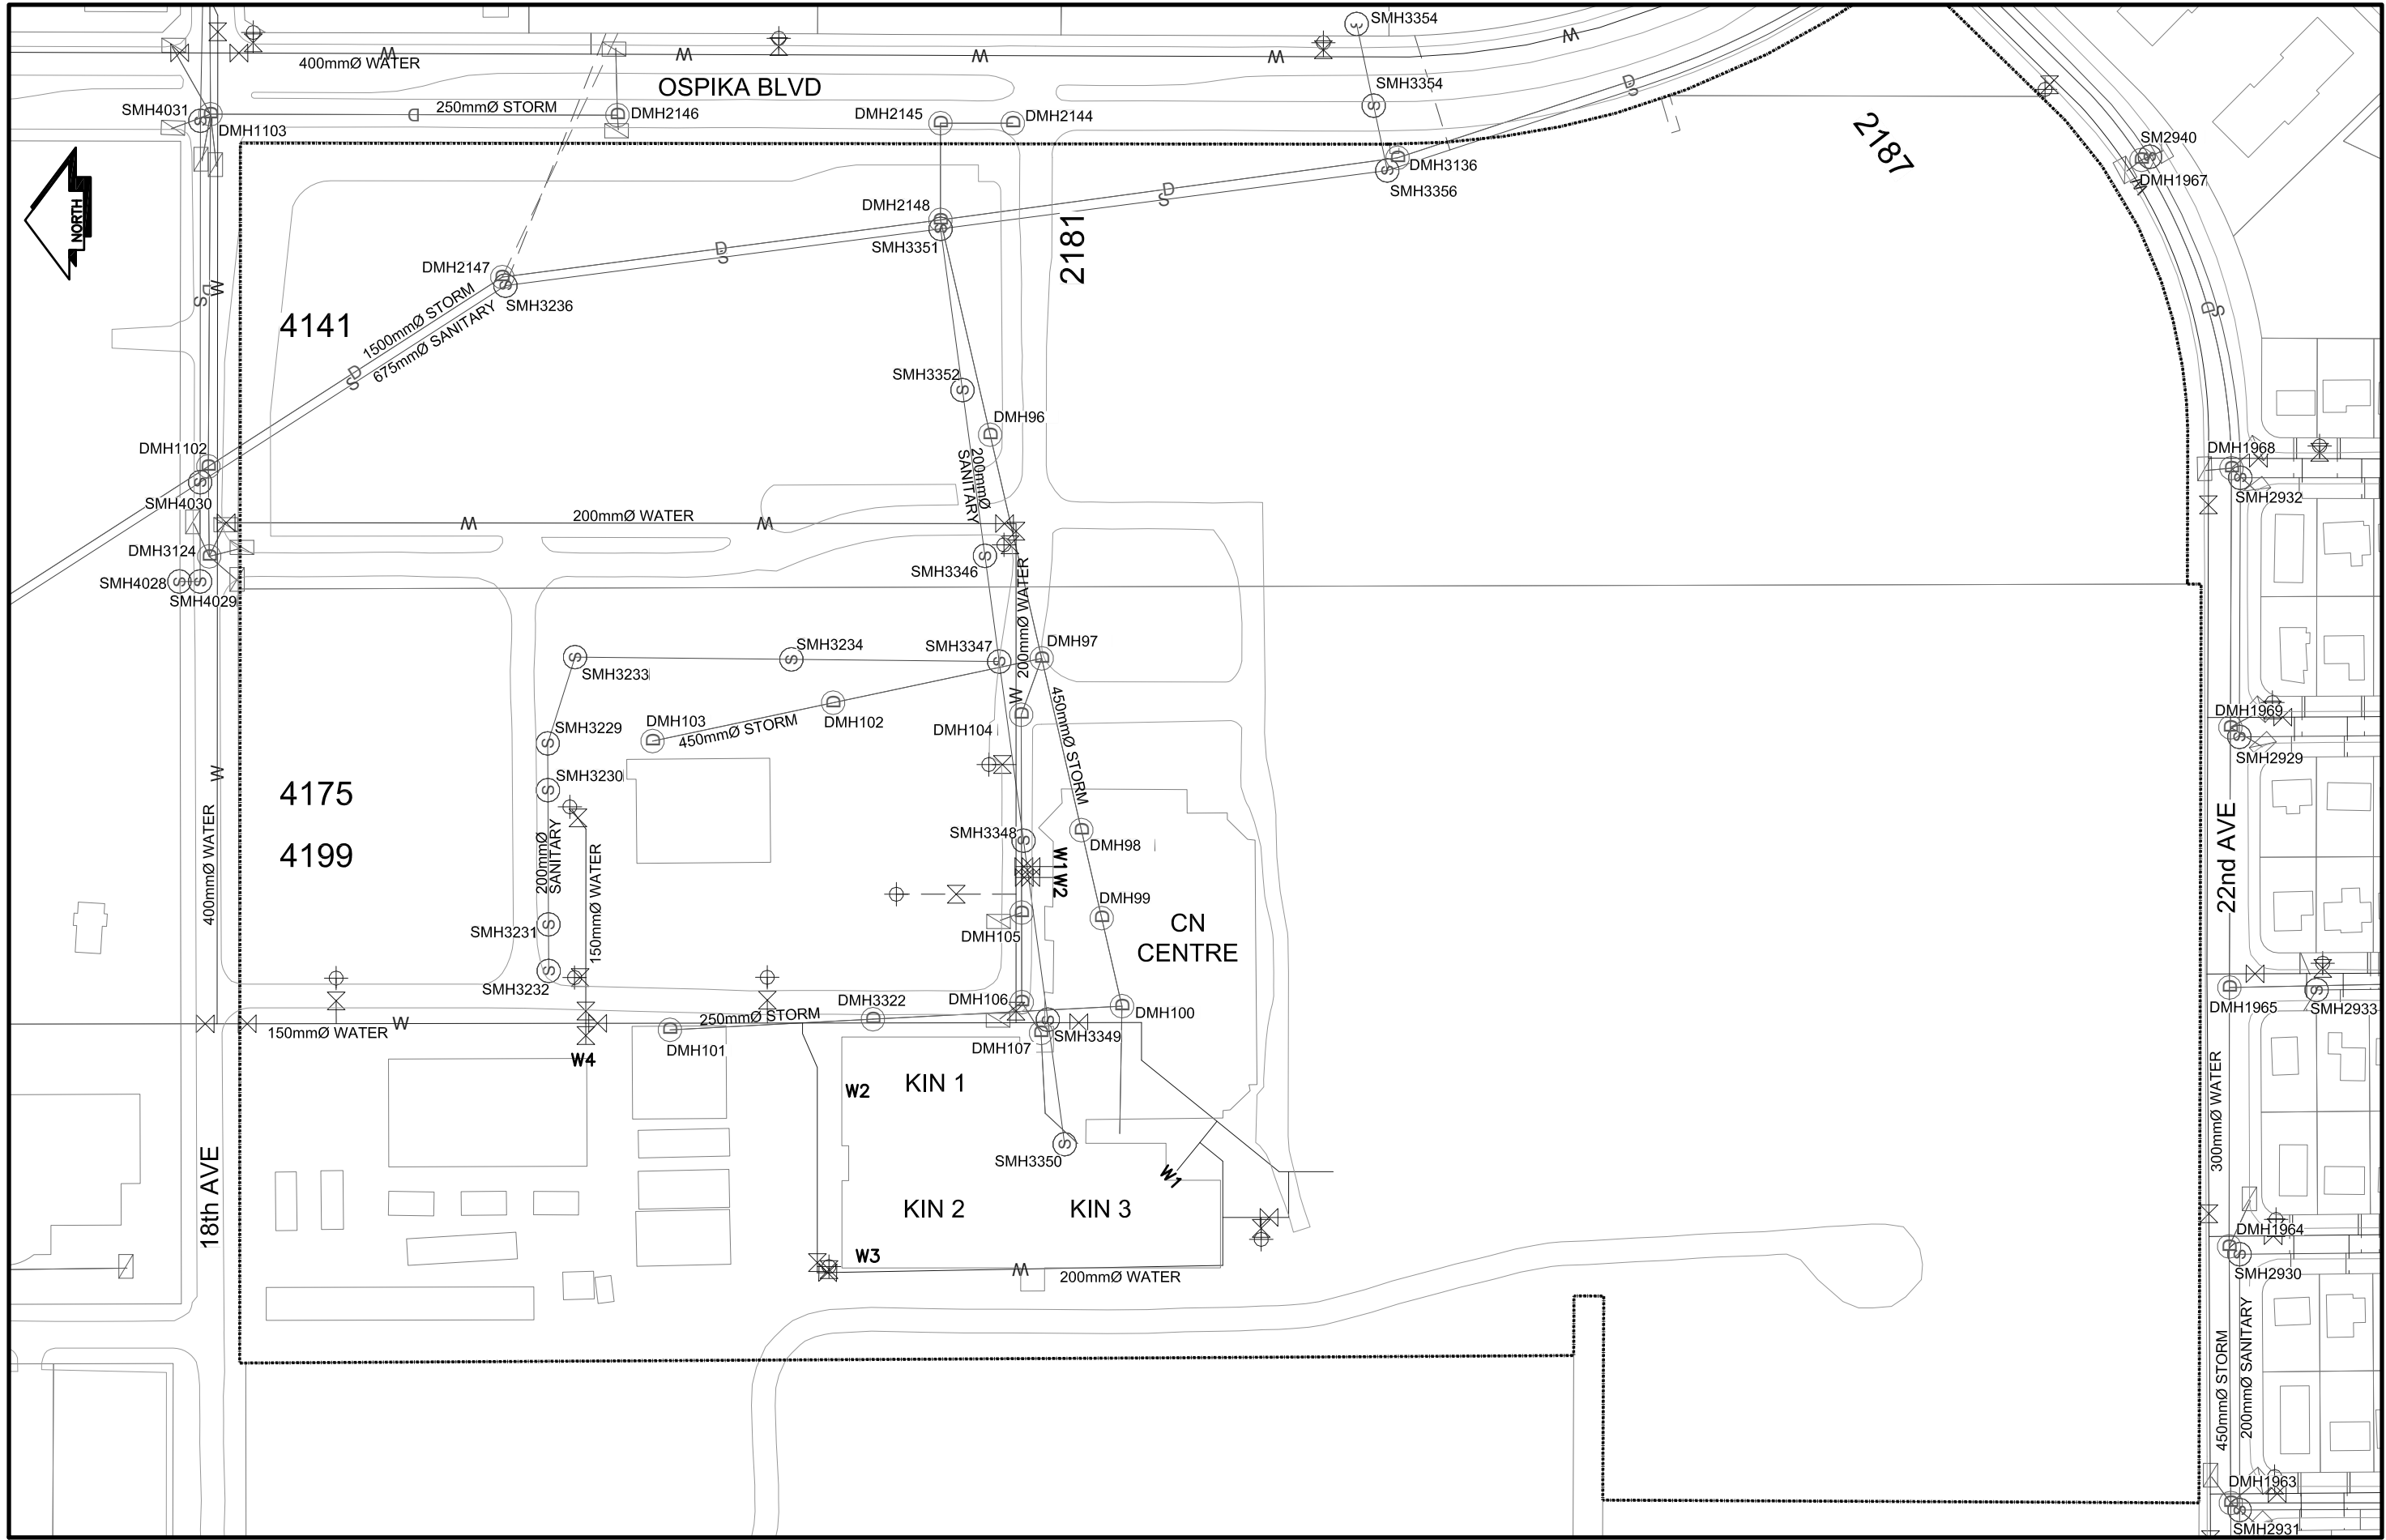

D

LEGEND:

CS

○

CURB STOP

CO

○

CLEAN OUT

---

W

WATER SERVICE

---

S

SANITARY SERVICE

---

D

STORM SERVICE

---

G

GAS