

City of Prince George
HISTORY SHEET

SHEET NUMBER

PID # 011-179-899

Legal: LOTS 9 BLOCK D.L. 8178 PLAN 18143

Address: 2921 PINEWOOD AVE.

Sanitary Connection: # 6361 SIZE 100 mm MATERIAL A.C. INV. 593,569 CONNECTED

Water Connection: # 6361 SIZE 20 mm MATERIAL CU. METER CONNECTED

Storm Connection: # SIZE mm MATERIAL INV. CONNECTED

Cash Receipt No's: WATER SANITARY STORM

CURB FROM PROPERTY LINE 3.657 m PAVEMENT WIDTH 12.801 m

B.C. HYDRO U/G UNDERGROUND CONNECTION

B.C. TELEPHONE U/G UNDERGROUND CONNECTION



INLAND GAS 3.048 m FROM R.

Information Sheets:

Comments: WITH THAW WIRE.

THE INFORMATION CONTAINED HEREIN IS FOR INTERNAL USE ONLY.

NOT TO BE RELIED UPON UNLESS CONFIRMED BY SITE INSPECTION AND/OR INVESTIGATION

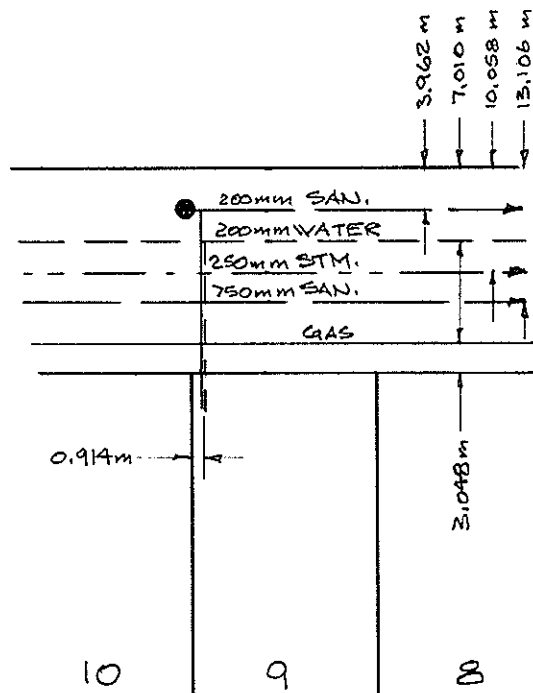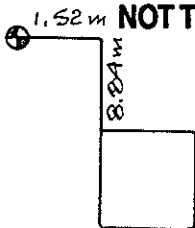

PINEWOOD AVE.

