



City of Prince George  
**History Sheet**

PID:	011270829
SD/MU:	
WO:	

Civic Address: ~~1019 Eastern St~~  
1021 Eastern St  
~~1027 Eastern St~~ 1025 Eastern St  
Legal Description: Lot: 15 District Lot: 745 Plan: 17833


Service Type	Diameter (mm)	Material	Invert Elev at main (m)	Invert Elev at property line (m)	Invert Elev at service end (m)	Distance into property (m)	Installation Date
Sanitary	Unknown	Unknown	-	-	-	-	1982
Water	150mm	AC	-	-	-	-	1979
Storm	N/A	N/A	-	-	-	-	

Service Connection Location	Sanitary (m)	Storm (m)
100mm sanitary service connected to San MH3605	-	
Distance from downstream Stm MH - towards upstream Stm MH -		

Power	Size	Communications	Size	Cable	Size	Gas	Size
BC Hydro	-	Telus	-	Shaw	-	FortisBC	-
Overhead Service		Overhead Service		Overhead Service			

Installed by:	Survey Date:	-
Comments: As per September 2016 locates.		
150mm AC water services to property downsized to 100mm at property line. - As per John Handler.		

**NOT TO SCALE** The information contained herein is for internal use only.  
Not to be relied on unless confirmed by site inspection and/or investigation.

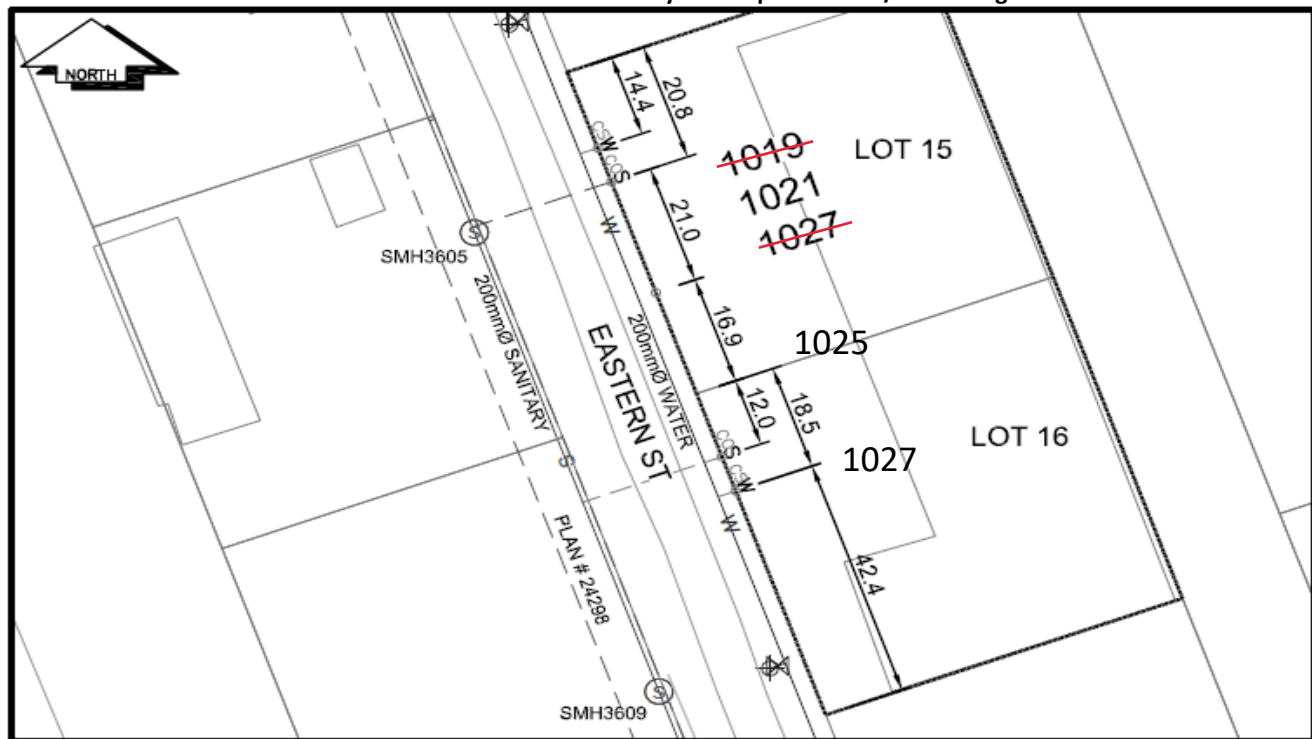

CS	CURB STOP	---	WATER SERVICE	---	STORM SERVICE
CO	CLEAN OUT	---	SANITARY SERVICE	---	GAS

**NOT TO SCALE**



City of Prince George  
**History Sheet**

PID:	011270829
SD/MU:	
WO:	

Civic Address: ~~1019 Eastern Street~~ 1021 Eastern St  
1021 Eastern Street 1025 Eastern St

Legal Description: Lot 15 District Lot 745 Plan 17833


Service Type	Diameter (mm)	Material	Invert Elev at main (m)	Invert Elev at property line (m)	Invert Elev at service end (m)	Distance into property (m)	Installation Date
Sanitary (S1)	150mm	PVC	-	-	-	-	2019
Sanitary (S2)	150mm	PVC	-	-	-	-	2019
Water	150mm	AC	-	-	-	-	1979
Storm	N/A	N/A	-	-	-	-	

Service Connection Location					Sanitary (m)	Storm (m)
Distance from downstream San MH	48.0m	towards upstream San MH	71.5m		-	
Distance from downstream Stm MH	-	towards upstream Stm MH	-			

Power	Size	Communications	Size	Cable	Size	Gas	Size
BC Hydro	-	Telus	-	Shaw	-	FortisBC	-
Overhead Service		Overhead Service		Unknown			

Installed by:	Survey Date:	-
Comments: 150mm AC water service to property line downsized to 100mm at property line - As per John Handler		

**NOT TO SCALE** The information contained herein is for internal use only.  
Not to be relied on unless confirmed by site inspection and/or investigation.

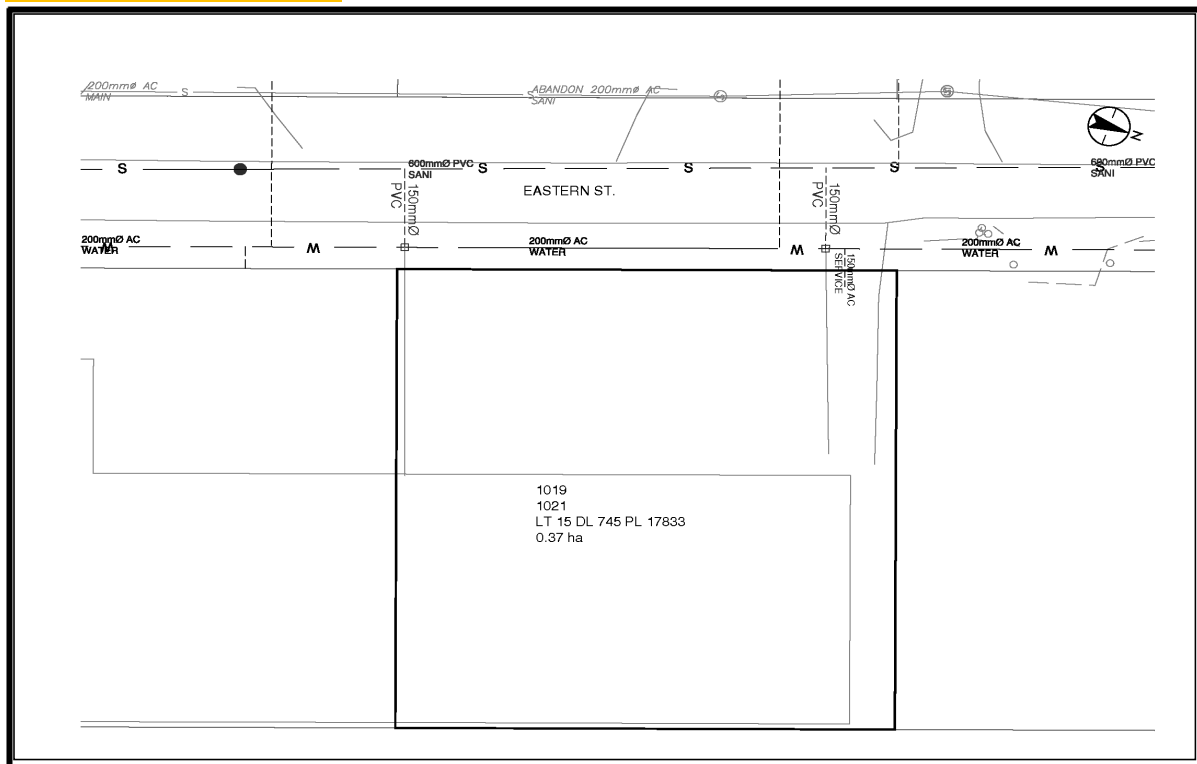

CS CURB STOP	WATER SERVICE	STORM SERVICE
CO CLEAN OUT	SANITARY SERVICE	GAS
WATER VALVE	FIRE HYDRANT	ENCUMBRANCE

**NOT TO SCALE**