



City of Prince George
History Sheet

PID:	011270837
SD/MU:	
WO:	

Civic Address: ~~1019 Eastern St~~
~~14021 Eastern St~~ 1025 Eastern St
1027 Eastern St 1027 Eastern St
Legal Description: Lot: 16 District Lot: 745 Plan: 17833


Service Type	Diameter (mm)	Material	Invert Elev at main (m)	Invert Elev at property line (m)	Invert Elev at service end (m)	Distance into property (m)	Installation Date
Sanitary	Unknown	Unknown	-	-	-	-	1982
Water	150mm	AC	-	-	-	-	1979
Storm	N/A	N/A	-	-	-	-	

Service Connection Location				Sanitary (m)	Storm (m)
Distance from downstream San MH	3605	towards upstream San MH	3609	51.10	
Distance from downstream Stm MH	-	towards upstream Stm MH	-		

Power	Size	Communications	Size	Cable	Size	Gas	Size
BC Hydro	-	Telus	-	Shaw	-	FortisBC	-
Overhead Service		Overhead Service		Overhead Service			

Installed by:		Survey Date:	-
Comments:	As per September 2016 locates.		
150mm AC water services to property downsized to 100mm at property line. - As per John Handler.			

NOT TO SCALE The information contained herein is for internal use only.
Not to be relied on unless confirmed by site inspection and/or investigation.

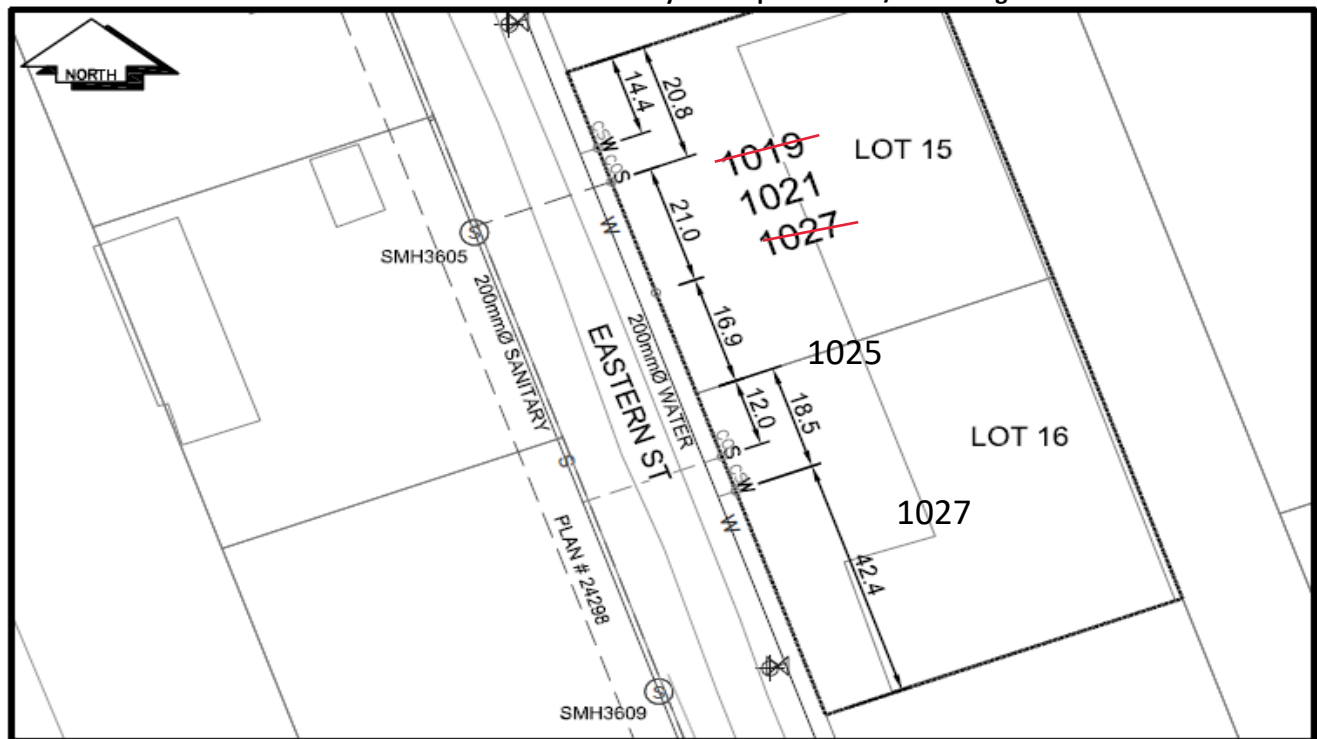

CS	CURB STOP	---	WATER SERVICE	---	STORM SERVICE
CO	CLEAN OUT	---	SANITARY SERVICE	---	GAS

NOT TO SCALE



City of Prince George
History Sheet

PID:	011270837
SD/MU:	
WO:	

Civic Address: 1025 Eastern Street
1027 Eastern Street

Legal Description: Lot 16 District Lot 745 Plan 17833


Service Type	Diameter (mm)	Material	Invert Elev at main (m)	Invert Elev at property line (m)	Invert Elev at service end (m)	Distance into property (m)	Installation Date
Sanitary	150mm	PVC	-	-	-	-	2019
Water	150mm	AC	-	-	-	-	1979
Storm	N/A	N/A	-	-	-	-	

Service Connection Location				Sanitary (m)	Storm (m)
Distance from downstream San MH	36.0m	towards upstream San MH	83.1m	-	
Distance from downstream Stm MH	-	towards upstream Stm MH	-		

Power	Size	Communications	Size	Cable	Size	Gas	Size
BC Hydro	-	Telus	-	Shaw	-	FortisBC	-
Overhead Service		Overhead Service		Unknown			

Installed by:	Survey Date:	-
Comments: 150mm AC water service to property downsized to 100mm at property line - as per John Handler		

NOT TO SCALE The information contained herein is for internal use only.
Not to be relied on unless confirmed by site inspection and/or investigation.

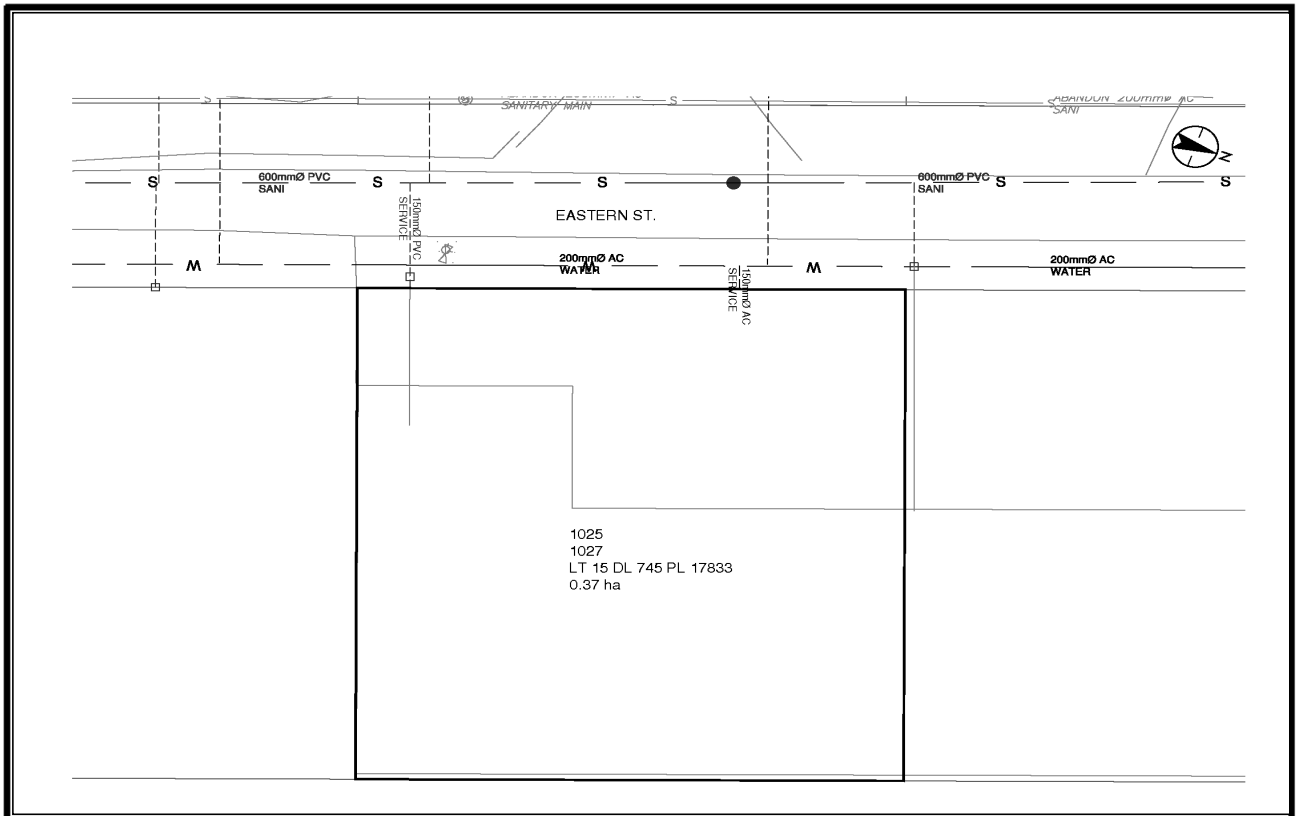

CS CURB STOP	— WATER SERVICE	— STORM SERVICE
CO CLEAN OUT	— SANITARY SERVICE	— GAS
⊗ WATER VALVE	⊗ FIRE HYDRANT	— ENCUMBRANCE

NOT TO SCALE