



City of Prince George History Sheet

PID:	011270853
SD/MU:	
WO:	

Civic Address: 1039 Eastern St

Legal Description: Lot: 18 District Lot: 745 Plan: 17833


Service Type	Diameter (mm)	Material	Invert Elev at main (m)	Invert Elev at property line (m)	Invert Elev at service end (m)	Distance into property (m)	Installation Date
Sanitary	200mm	AC	-	-	-	-	1982
Water	150mm	AC	-	-	-	-	1979
Storm	N/A	N/A	-	-	-	-	

Service Connection Location				Sanitary (m)	Storm (m)
Distance from downstream San MH	3609	towards upstream San MH	3644	105.00	
Distance from downstream Stm MH	-	towards upstream Stm MH	-		

Power	Size	Communications	Size	Cable	Size	Gas	Size
BC Hydro	-	Telus	-	Shaw	-	FortisBC	-
Overhead Service		Overhead Service		Overhead Service			

Installed by:	Survey Date:	-
Comments: History sheet made from existing history sheet and service connection info.		
150mm AC water services to property downsized to 100mm at property line. - As per John Handler.		

NOT TO SCALE The information contained herein is for internal use only.
Not to be relied on unless confirmed by site inspection and/or investigation.

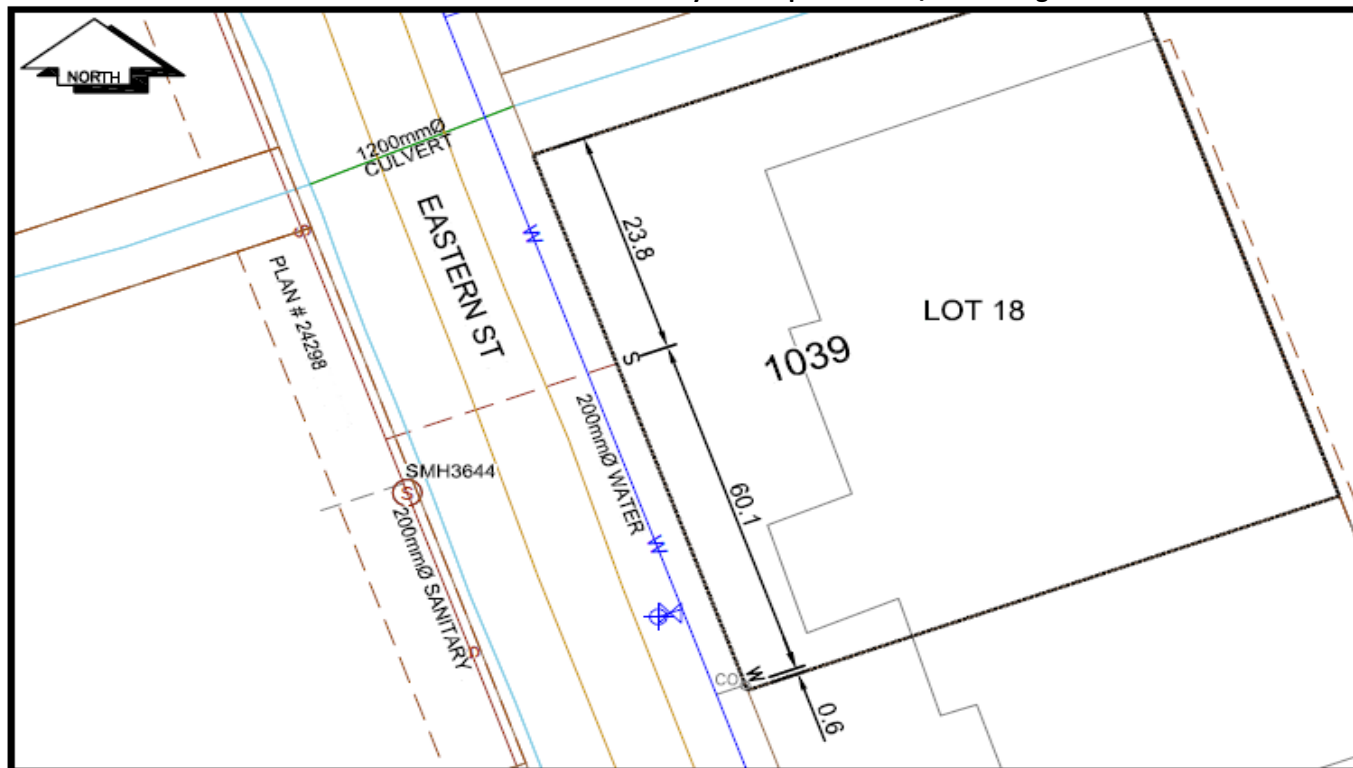

CS ^o CURB STOP	--- WATER SERVICE	--- STORM SERVICE
CO ^o CLEAN OUT	--- SANITARY SERVICE	--- G GAS

NOT TO SCALE