



# City of Prince George History Sheet

PID:	011271353
SD/MU:	
WO:	

Civic Address: 1020 Eastern St  
Legal Description: Lot: 9 District Lot: 745 Plan: 17833


Service Type	Diameter (mm)	Material	Invert Elev at main (m)	Invert Elev at property line (m)	Invert Elev at service end (m)	Distance into property (m)	Installation Date
Sanitary	Unknown	Unknown	-	-	-	-	1982
Water	150mm	AC	-	-	-	-	1979
Storm	N/A	N/A	-	-	-	-	

Service Connection Location					Sanitary (m)	Storm (m)
Distance from downstream San MH	4145	towards upstream San MH	3609		92.50	
Distance from downstream Stm MH	-	towards upstream Stm MH	-			

Power	Size	Communications	Size	Cable	Size	Gas	Size
BC Hydro	-	Telus	-	Shaw	-	FortisBC	-
Overhead Service		Overhead Service		Overhead Service			

Installed by:	Survey Date:	-
Comments: Sanitary service location from old history sheet info and should be confirmed.		
150mm AC water services to property downsized to 100mm at property line. - As per John Handler.		

**NOT TO SCALE** The information contained herein is for internal use only.  
Not to be relied on unless confirmed by site inspection and/or investigation.

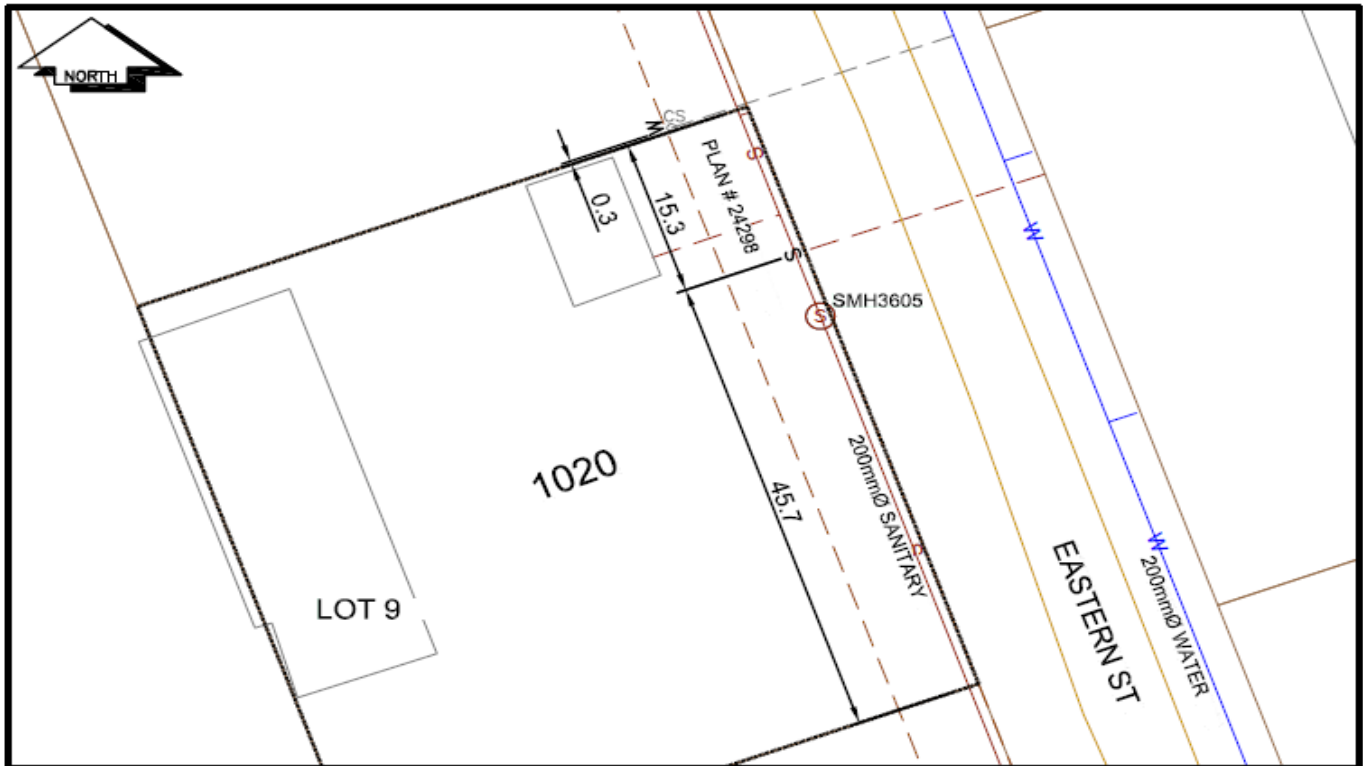

LEGEND:	SANITARY	CS CURB STOP	CO CLEAN OUT	STORM	WATER SERVICE	SANITARY SERVICE	STORM SERVICE	GAS
---------	----------	--------------	--------------	-------	---------------	------------------	---------------	-----

**NOT TO SCALE**