

City of Prince George
HISTORY SHEET

SHEET NUMBER

PID # 011445301

Legal: LOT'S 62 BLOCK D.L. 913 PLAN 16511

Address: 121 AITKEN CRES.

Sanitary Connection: # 5718 SIZE 100 mm MATERIAL A.C. INV. 584.773 CONNECTED

Water Connection: # 5718 SIZE 20 mm MATERIAL C.U. METER CONNECTED

Storm Connection: # SIZE mm MATERIAL INV. CONNECTED

Cash Receipt No's: WATER SANITARY STORM

CURB FROM PROPERTY LINE 4.877 m PAVEMENT WIDTH 10.363 m

B.C. HYDRO U/G UNDERGROUND CONNECTION



B.C. TELEPHONE U/G UNDERGROUND CONNECTION

INLAND GAS 3.048 m FROM NORTH SIDE OF AITKEN.

Information Sheets:

Comments:

THE INFORMATION CONTAINED HEREIN IS FOR INTERNAL USE ONLY.
NOT TO BE RELIED UPON UNLESS CONFIRMED BY SITE INSPECTION AND/OR INVESTIGATION

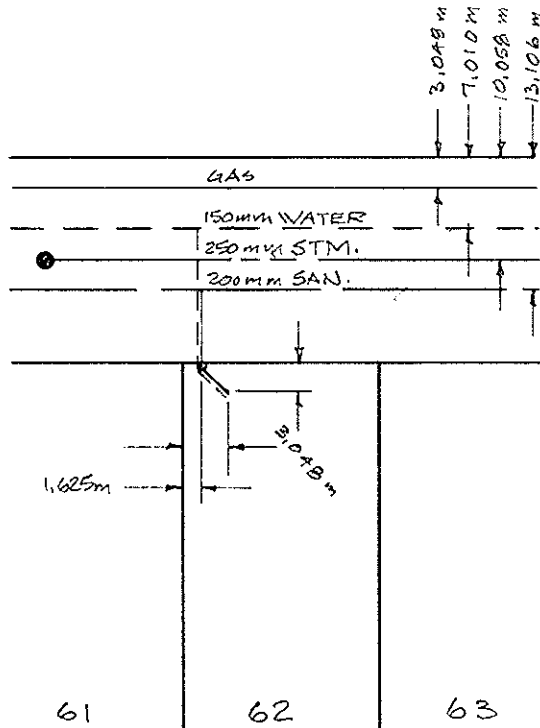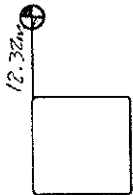

AITKEN CRES.

