

City of Prince George
HISTORY SHEET

SHEET NUMBER

PID # 011 467029

Legal: LOTS 51 BLOCK D.L. 777 PLAN 17 401

Address: 2090 McDONALD AVE.

Sanitary Connection: # 6448 SIZE 100 mm MATERIAL A.C. INV. 580.944 CONNECTED

Water Connection: # 6448 SIZE 20 mm MATERIAL C.U. METER CONNECTED

Storm Connection: # SIZE mm MATERIAL INV. CONNECTED

Cash Receipt No's: WATER SANITARY STORM

CURB FROM PROPERTY LINE 4.877 m PAVEMENT WIDTH 10.363 m

B.C. HYDRO 4/G UNDERGROUND CONNECTION



B.C. TELEPHONE 4/G UNDERGROUND CONNECTION

INLAND GAS 3.048 m FROM R

Information Sheets:

Comments: WITH THAW WIRE.

THE INFORMATION CONTAINED HEREIN IS FOR INTERNAL USE ONLY.
NOT TO BE RELIED UPON UNLESS CONFIRMED BY SITE INSPECTION AND/OR INVESTIGATION

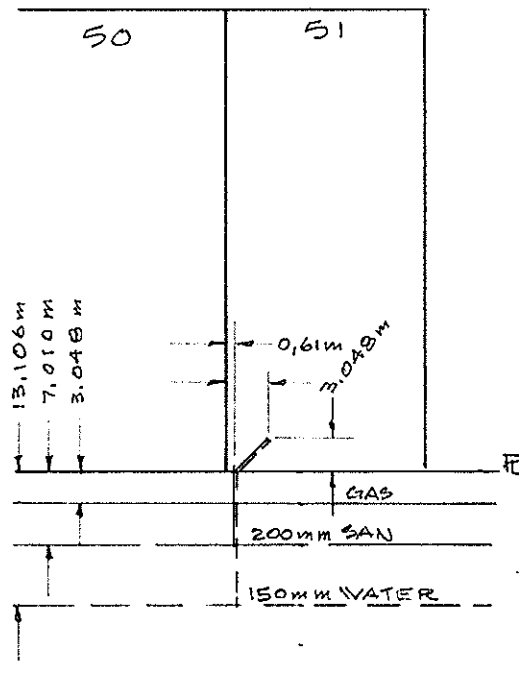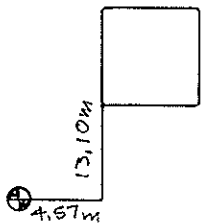

MC DONALD AVE.