



| | |
|--------|-----------|
| PID: | 011468131 |
| SD/MU: | |
| WO: | |

Legal Description: Lot: 21 REM District Lot: 777 Plan: 17401


| Service Type | Diameter (mm) | Material | Invert Elev at main (m) | Invert Elev at property line (m) | Invert Depth at service end (m) | Distance into property (m) | Installation Date |
|--------------|---------------|----------|-------------------------|----------------------------------|---------------------------------|----------------------------|-------------------|
| Sanitary | 100mm | AC | - | 585.43 | 2.77 | - | January 1970 |
| Water | 20mm | Copper | - | - | - | - | January 1968 |
| Storm | N/A | N/A | - | - | - | - | |







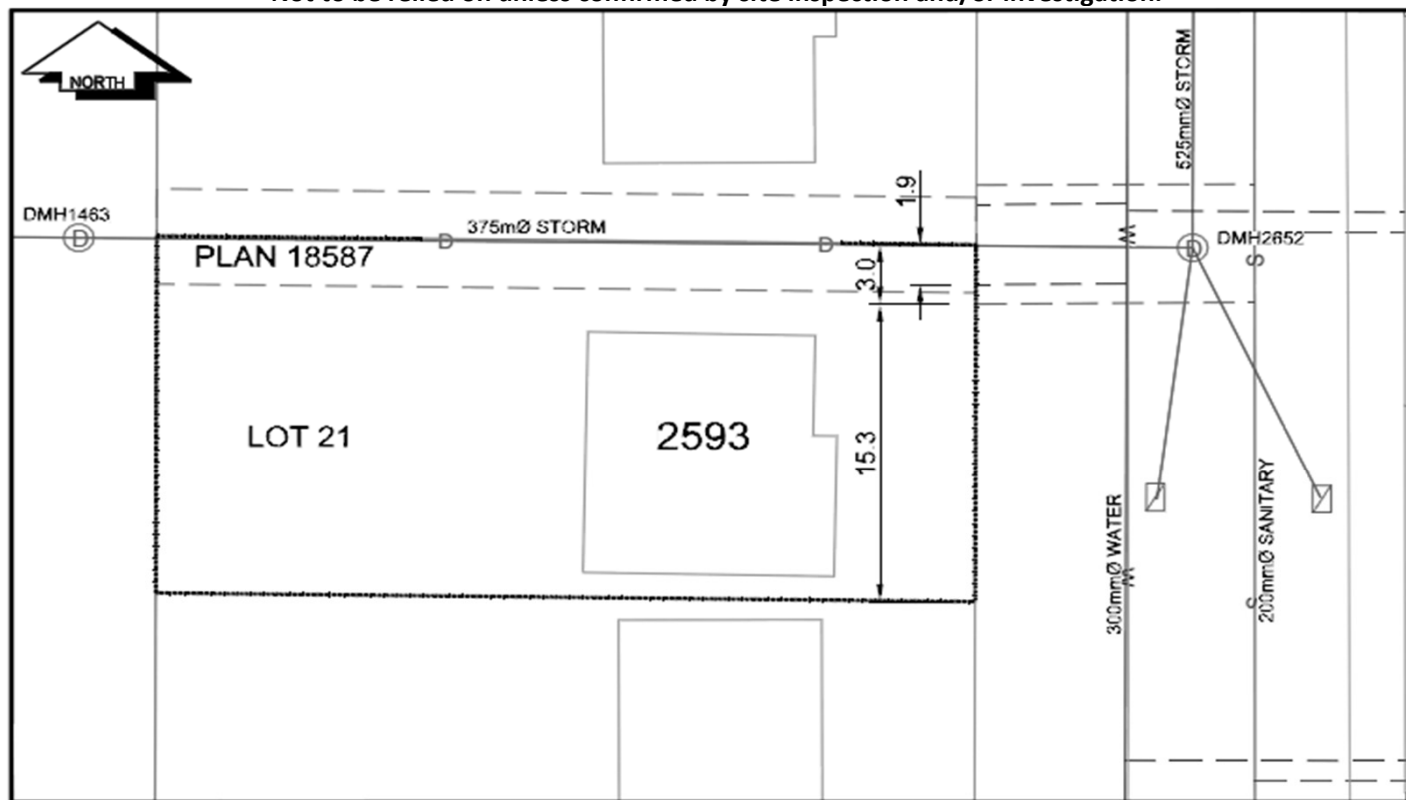


| Service Connection Location | | | | Sanitary (m) | Storm (m) |
|---------------------------------|------|-------------------------|------|--------------|-----------|
| Distance from downstream San MH | 1716 | towards upstream San MH | 2976 | - | |
| Distance from downstream Stm MH | - | towards upstream Stm MH | - | | |

| | | | | | | | |
|---------------------|-------------|-----------------------|-------------|---------------------|-------------|------------|-------------|
| Power | Size | Communications | Size | Cable | Size | Gas | Size |
| BC Hydro | - | Telus | - | Shaw | - | FortisBC | - |
| Underground Service | | Underground Service | | Underground Service | | | |

| | | | |
|---------------|-------------------------------------|--------------|---|
| Installed by: | | Survey Date: | - |
| Comments: | Water service located October 2017+ | | |
| | | | |
| | | | |

NOT TO SCALE The information contained herein is for internal use only.
Not to be relied on unless confirmed by site inspection and/or investigation.



| | | | | | | |
|---------|---|-------------|---|------------------|---|---------------|
| LEGEND: |  | CURB STOP |  | WATER SERVICE |  | STORM SERVICE |
| |  | CLEAN OUT |  | SANITARY SERVICE |  | GAS |
| |  | WATER VALVE |  | FIRE HYDRANT |  | ENCUMBRANCE |
| | | | | | | |

NOT TO SCALE