



City of Prince George  
**History Sheet**

PID:	011547308
SD/MU:	
WO:	

Civic Address: 2525 McBride Cres  
Legal Description: Lot: A District Lot: 343 Plan: 17206


Service Type	Diameter (mm)	Material	Invert Elev at main (m)	Invert Elev at property line (m)	Invert Elev at service end (m)	Distance into property (m)	Installation Date
Sanitary	100mm	AC	-	582.58	-	-	January 1957
Water	20mm	Copper	-	-	-	-	January 1957
Storm	N/A	N/A	-	-	-	-	

Service Connection Location				Sanitary (m)	Storm (m)
Distance from downstream San MH	3092	towards upstream San MH	3090	30.70	
Distance from downstream Stm MH	-	towards upstream Stm MH	-		

Power	Size	Communications	Size	Cable	Size	Gas	Size
BC Hydro	-	Telus	-	Shaw	-	FortisBC	-
Overhead Service		Overhead Service		Overhead Service			

Installed by:	Survey Date:	-
Comments: Sanitary service confirmed Mar 2013		
Overhead power in laneway		

**NOT TO SCALE** The information contained herein is for internal use only.  
Not to be relied on unless confirmed by site inspection and/or investigation.

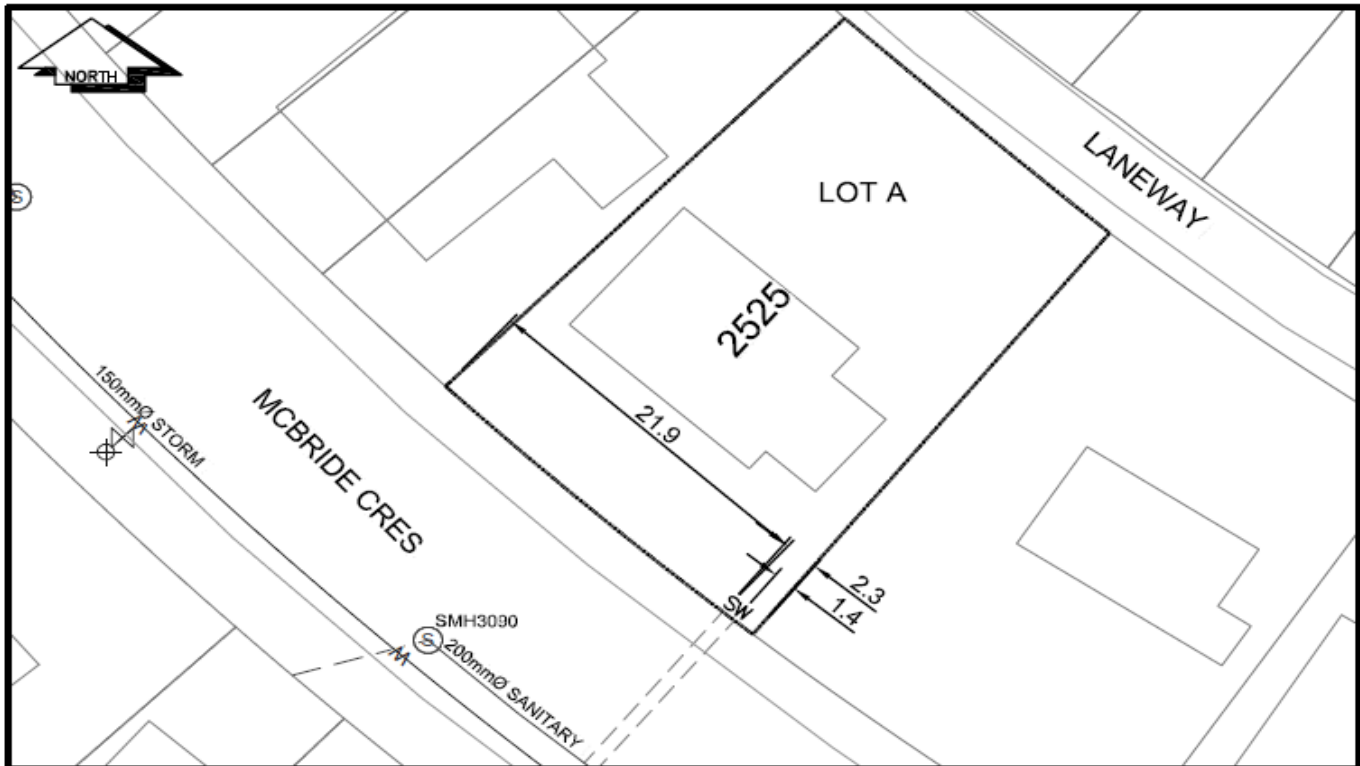

CS <sup>o</sup> CURB STOP	--- WATER SERVICE	--- STORM SERVICE
CO <sup>o</sup> CLEAN OUT	--- SANITARY SERVICE	--- GAS
⊗ WATER VALVE	⊗ FIRE HYDRANT	--- ENCUMBERANCE

**NOT TO SCALE**