

City of Prince George  
HISTORY SHEET

011572809

SHEET NUMBER **11089** Roll Number

Legal: LOT'S **4** BLOCK D.L. **4040** PLAN **8833**

Address: **4202 MYTTING ST. OR SHAMROCK**

Sanitary Connection: # **13273** SIZE **4"** MATERIAL INV. **2126.97** CONNECTED

Water Connection # SIZE **20mm** MATERIAL **Cu** METER CONNECTED

Storm Connection: # SIZE MATERIAL INV. CONNECTED

Cash Receipt No's: WATER SANITARY STORM

CURB FROM PROPERTY LINE PAVEMENT WIDTH

B.C. HYDRO UNDERGROUND CONNECTION


B.C. TELEPHONE UNDERGROUND CONNECTION

INLAND GAS

Information Sheets:

Comments: THE INFORMATION CONTAINED HEREIN IS FOR INTERNAL  
USE ONLY. NOT TO BE RELIED UPON UNLESS CONFIRMED  
BY SITE INSPECTION AND/OR INVESTIGATION.

SITE PLAN N.T.S.

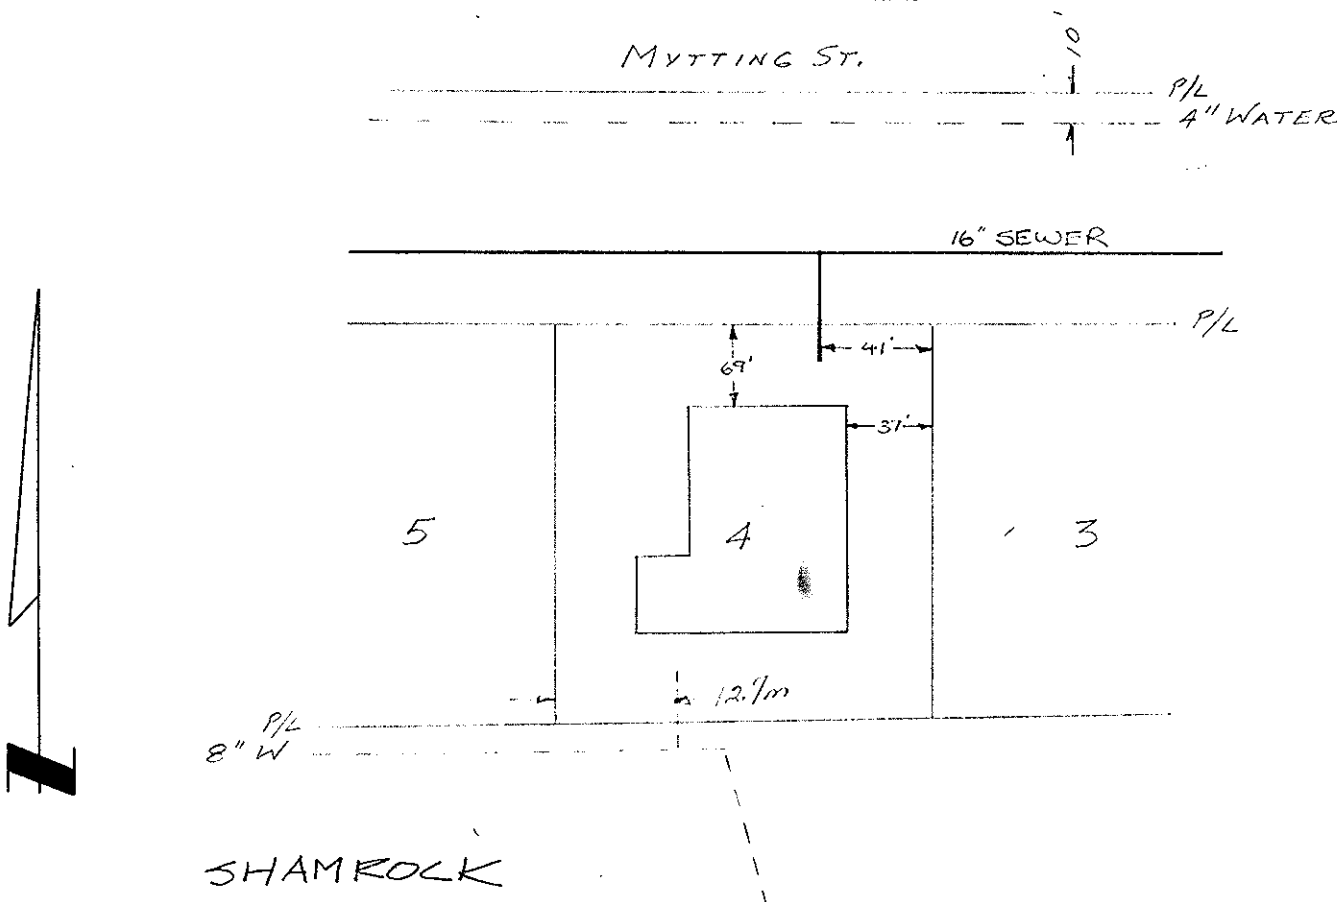

## STORM

**Sanitary History:**

### Storm History: