

City of Prince George HISTORY SHEET

SHEET NUMBER

Roll Number 011577/51

Legal: LOT'S B BLOCK B D.L. 753 PLAN 17188

Address: COWART ROAD

Sanitary Connection: # SIZE 100mm ϕ MATERIAL PVC INV. CONNECTED

Water Connection # SIZE 50mm ϕ MATERIAL COPPER METER CONNECTED

Storm Connection: # SIZE MATERIAL INV. CONNECTED

Cash Receipt No's: WATER SANITARY STORM

CURB FROM PROPERTY LINE PAVEMENT WIDTH

B.C. HYDRO UNDERGROUND CONNECTION


B.C. TELEPHONE UNDERGROUND CONNECTION

INLAND GAS

Information Sheets: REF. DRAWINGS L&M ENGINEERING LTD 1037-04-01 (001 & 002)

Comments: PACIFIC WESTERN HELICOPTERS

**THE INFORMATION CONTAINED HEREIN IS FOR INTERNAL USE ONLY.
NOT TO BE RELIED UPON UNLESS CONFIRMED BY SITE INSPECTION AND/OR INVESTIGATION**

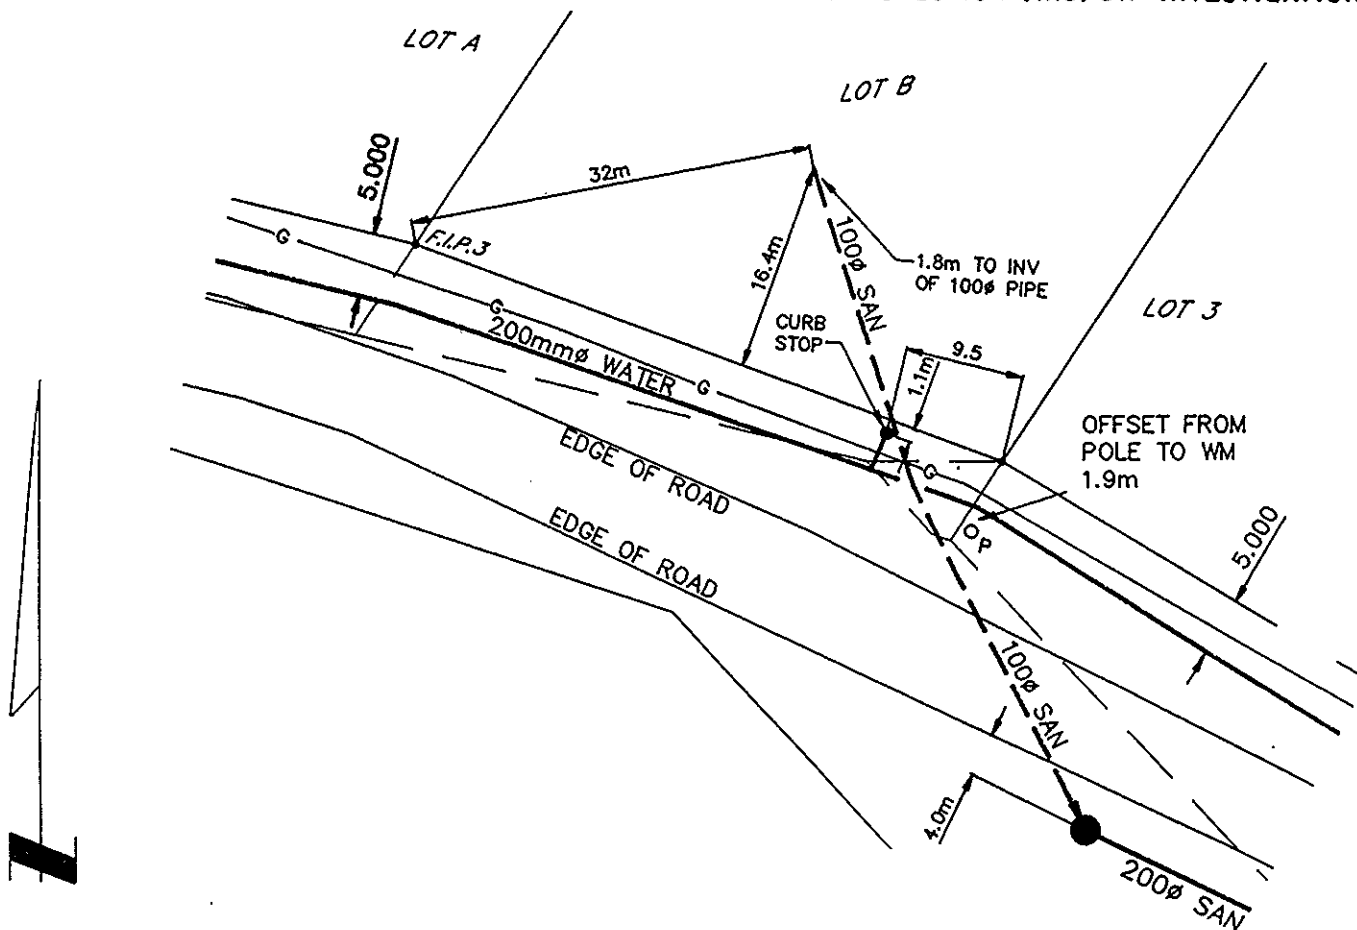

N.T.S.