

# City of Prince George

## HISTORY SHEET

5

SHEET NUMBER

PID # 011583967

Legal: LOTS 140 BLOCK D.L. 2610 PLAN 16510

Address: 149-151 PIONEER AVE.

Sanitary Connection: # 5955 SIZE 100 mm MATERIAL A.C. INV. 601.378 CONNECTED

Water Connection: # 5955 SIZE 20 mm MATERIAL C.U. METER CONNECTED

Storm Connection: # SIZE mm MATERIAL INV. CONNECTED

Cash Receipt No's: WATER SANITARY STORM

CURB FROM PROPERTY LINE 4.877 m PAVEMENT WIDTH 10.363 m

B.C. HYDRO U/G UNDERGROUND CONNECTION



B.C. TELEPHONE U/G UNDERGROUND CONNECTION

INLAND GAS 3.048 m FROM P.

Information Sheets:

Comments:

**THE INFORMATION CONTAINED HEREIN IS FOR INTERNAL USE ONLY.  
NOT TO BE RELIED UPON UNLESS CONFIRMED BY SITE INSPECTION AND/OR INVESTIGATION**

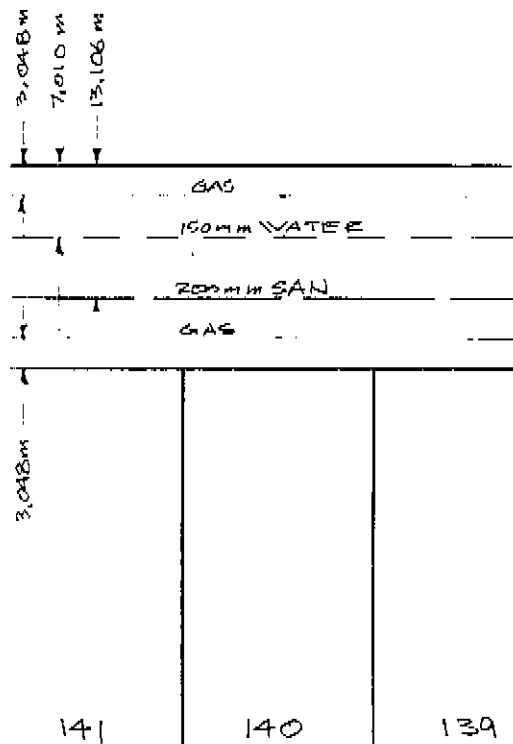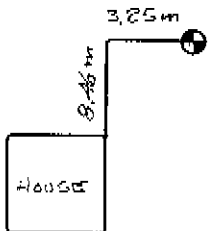

PIONEER AVE.

