



City of Prince George  
**History Sheet**

PID:	011645288
SD/MU:	
WO:	

Civic Address: 138 McLean Dr  
Legal Description: Lot: 23 District Lot: 1427 Plan: 16997


Service Type	Diameter (mm)	Material	Invert Elev at main (m)	Invert Elev at property line (m)	Invert Depth at service end (m)	Distance into property (m)	Installation Date
Sanitary	100mm	AC	-	603.48	3.09	-	December 1966
Water	20mm	Copper	-	-	-	-	December 1965
Storm	N/A	N/A	-	-	-	-	

Service Connection Location				Sanitary (m)	Storm (m)
Distance from downstream San MH	2330	towards upstream San MH	2336	94.37	
Distance from downstream Stm MH	-	towards upstream Stm MH	-		

Power	Size	Communications	Size	Cable	Size	Gas	Size
BC Hydro	-	Telus	-	Shaw	-	FortisBC	-
Underground Service		Underground Service		Underground Service			

Installed by:	Survey Date:	-
Comments: Water service confirmed October 2016		

**NOT TO SCALE** The information contained herein is for internal use only.  
Not to be relied on unless confirmed by site inspection and/or investigation.

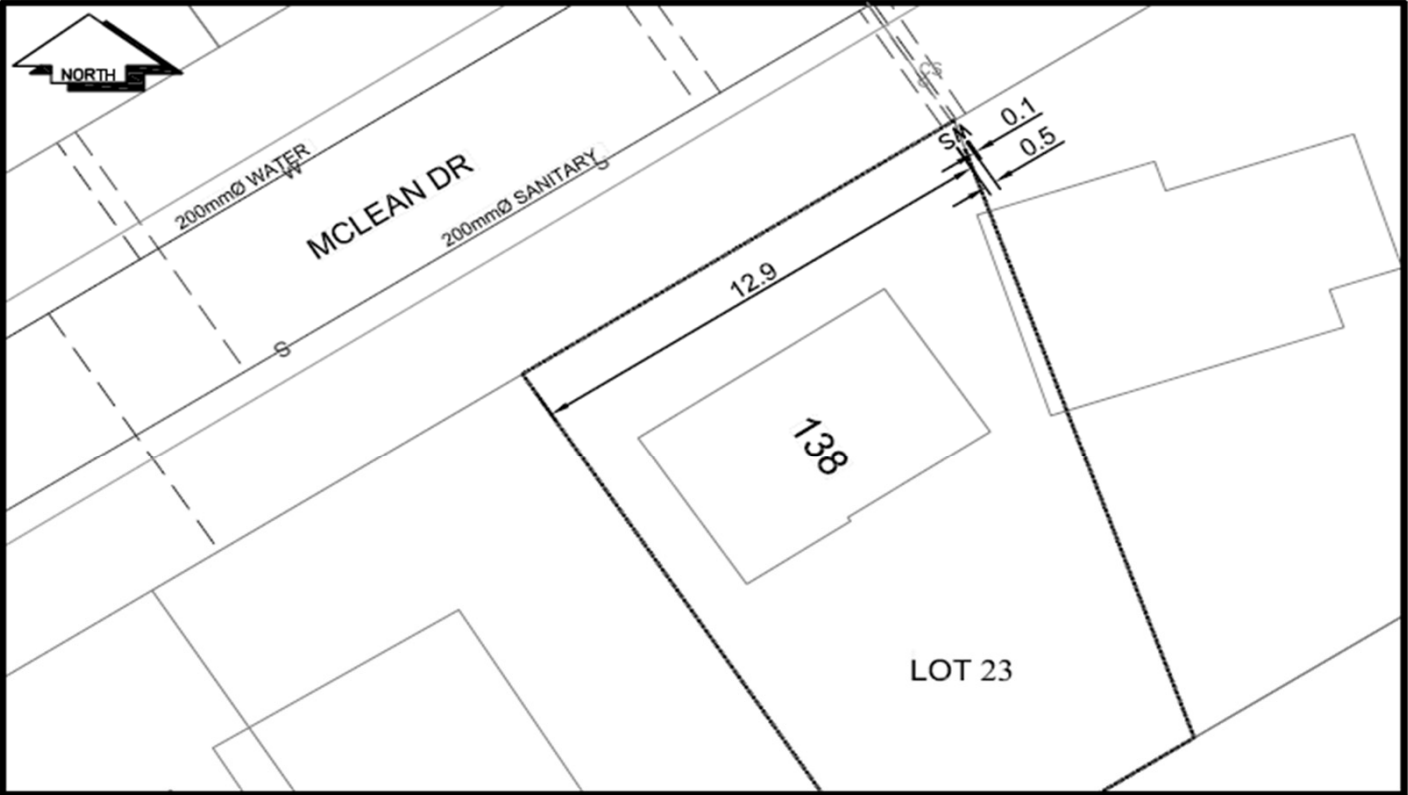

CS <sup>o</sup> CURB STOP	--- WATER SERVICE	--- STORM SERVICE
CO <sup>o</sup> CLEAN OUT	--- SANITARY SERVICE	--- GAS
⊗ WATER VALVE	⊗ FIRE HYDRANT	--- ENCUMBRANCE

**NOT TO SCALE**