

City of Prince George  
HISTORY SHEET

SHEET NUMBER

PID # 011-687-941

Legal: LOT'S 3 BLOCK 2 D.L. 8178 PLAN 16808

Address: 119 FERN CRES.

Sanitary Connection: # 6203 SIZE 100 mm MATERIAL A.C. INV. 586.909 CONNECTED

Water Connection: # 6203 SIZE 20 mm MATERIAL C.U. METER CONNECTED

Storm Connection: # SIZE mm MATERIAL INV. CONNECTED

Cash Receipt No's: WATER SANITARY STORM

CURB FROM PROPERTY LINE 4.877 m PAVEMENT WIDTH 10.363

B.C. HYDRO U/G UNDERGROUND CONNECTION


B.C. TELEPHONE U/G UNDERGROUND CONNECTION

INLAND GAS 3.048 m FROM F.R.

Information Sheets:

Comments: WITH THAW WIRE.

THE INFORMATION CONTAINED HEREIN IS FOR INTERNAL USE ONLY.  
NOT TO BE RELIED UPON UNLESS CONFIRMED BY SITE INSPECTION AND/OR INVESTIGATION

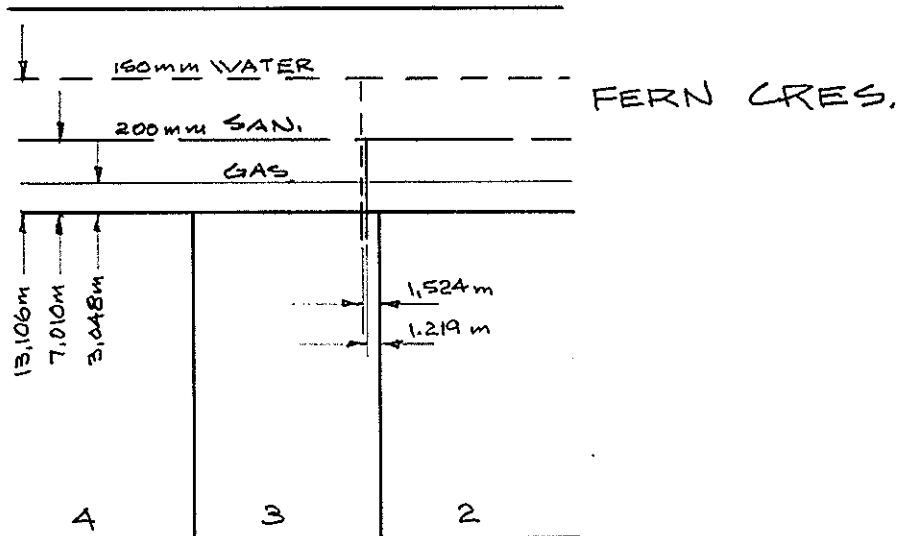


# REPORT TO RECORDS

## WATER SERVICE INFORMATION

Lot No. 3/2/8178/16808 Block \_\_\_\_\_ D.L. \_\_\_\_\_Address 119 Fern CresSize of Connection ☐ 1/2" ☒ 3/4" ☐ Other \_\_\_\_\_Type of Connection ☒ Copper ☐ IronThaw Wire ☐ Yes ☒ No

## LOCATION SKETCH

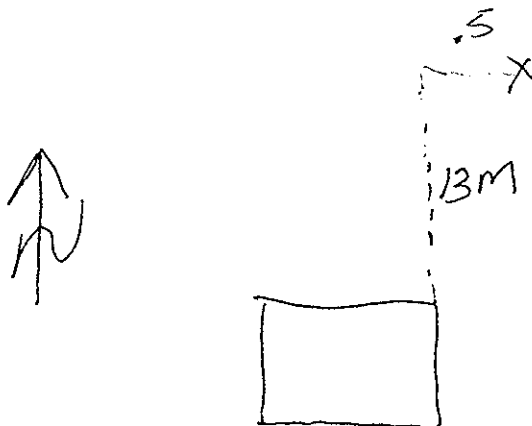Field Location By JH Date Apr 14/96

Checked by: \_\_\_\_\_