

City of Prince George
HISTORY SHEET

SHEET NUMBER

PID # 011-688-017

Legal: LOTS 13 BLOCK 2 D.L. 8178 PLAN 16808

Address: 244 LAUREL CRES.

Sanitary Connection: # 6213 SIZE 100 mm MATERIAL A.C. INV. 587.123 CONNECTED

Water Connection: # 6213 SIZE 20 mm MATERIAL C.U. METER CONNECTED

Storm Connection: # SIZE mm MATERIAL INV. CONNECTED

Cash Receipt No's: WATER SANITARY STORM

CURB FROM PROPERTY LINE 4.572 m PAVEMENT WIDTH 9.144 m

B.C. HYDRO U/G UNDERGROUND CONNECTION


B.C. TELEPHONE U/G UNDERGROUND CONNECTION

INLAND GAS 3.048 m

Information Sheets:

Comments: WITH THAW WIRE.

THE INFORMATION CONTAINED HEREIN IS FOR INTERNAL USE ONLY.
NOT TO BE RELIED UPON UNLESS CONFIRMED BY SITE INSPECTION AND/OR INVESTIGATION

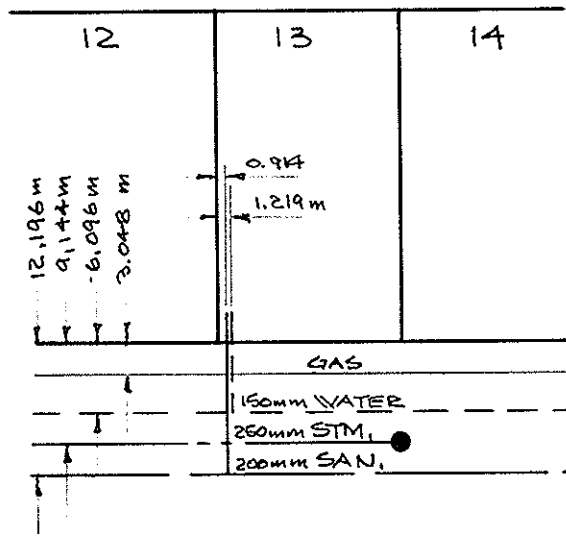

LAUREL CRES.