

City of Prince George HISTORY SHEET

SHEET NUMBER							Roll Number 0/1-688-033			
Legal:	LOT'S	16	BLOCK	2		D.L.	8178	PLAN	16808	
Address:	232	LAUREL	CRE	55						
Sanitary Co	onnection:	6216	SIZE	100 mm	MATERIAL	· · · · · · · · · · · · · · · · · · ·	INV.	····	CONNECTED	
Water Con	nection #	6216	SIZE	20 mm	MATERIAL	Cu	METER		CONNECTED	
Storm Con	nection:		SIZE		MATERIAL		INV.		CONNECTED	
Cash Recei	pt No's:	WATER			SANITARY			STORM		
CURB FROM F		PAVEMENT WIDTH								
B.C. HYDRO	UNDERGROUND CONNECTION									
B.C. TELEPHONE			UNDERGROUND CONNECTION							
INLAND GAS										
Information Sheets:										
Comments										
									\	

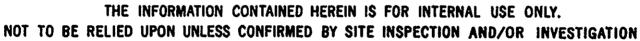

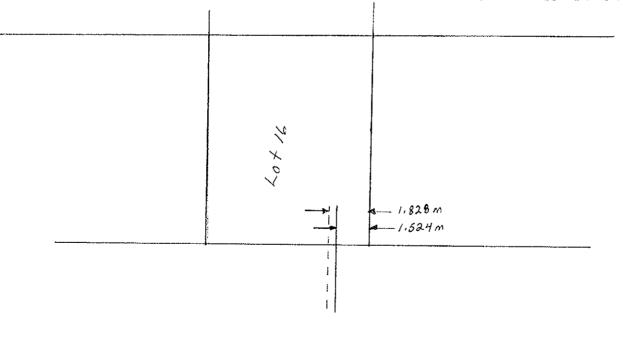

LAUREL CRES.