

City of Prince George
HISTORY SHEET

SHEET NUMBER

PID # 011-688-173

Legal: LOT'S 18 BLOCK 3 D.L. 8178 PLAN 16 808

Address: 224 CHERRY AVE.

Sanitary Connection: # 6238 SIZE 100 mm MATERIAL A.C. INV. 586.193 CONNECTED

Water Connection: # 6238 SIZE 20 mm MATERIAL C.U. METER CONNECTED

Storm Connection: # SIZE mm MATERIAL INV. CONNECTED

Cash Receipt No's: WATER SANITARY STORM

CURB FROM PROPERTY LINE 4.877 m PAVEMENT WIDTH 10.363 m

B.C. HYDRO U/G UNDERGROUND CONNECTION


B.C. TELEPHONE U/G UNDERGROUND CONNECTION

INLAND GAS 3.048 m FROM R.L.

Information Sheets:

Comments: WITH THAW WIRE.

THE INFORMATION CONTAINED HEREIN IS FOR INTERNAL USE ONLY.
NOT TO BE RELIED UPON UNLESS CONFIRMED BY SITE INSPECTION AND/OR INVESTIGATION

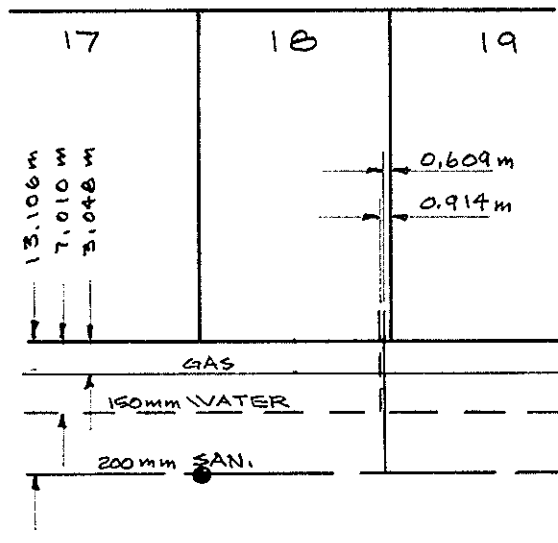

CHERRY AVE.