

# City of Prince George

## HISTORY SHEET

PID: **011699817**

Scale: 1:1000

Legal: 19

D.L.: 2424

PLAN: 10807

Address: **5026CHIEF LAKE ROAD**

Sanitary Connection: 16647	SIZE: 100mmØ	MATERIAL: PVC	INV. 759.93m	CONNECTED
----------------------------	--------------	---------------	--------------	-----------

Water Connection:	SIZE: 19mmØ	MATERIAL: COPPER	INV. 760.11m	CONNECTED
-------------------	-------------	------------------	--------------	-----------

Storm Connection:	SIZE	MATERIAL	INV.	
-------------------	------	----------	------	--

Cash Receipt No's:	WATER	SANITARY	STORM
--------------------	-------	----------	-------

CURB FROM PROPERTY LINE	PAVEMENT WIDTH
-------------------------	----------------

HYDRO	-	O/H CONNECTION
-------	---	----------------


TELEPHONE	-	O/H CONNECTION
-----------	---	----------------

GAS	-	
-----	---	--

Information Sheets: -

Comments:	CS <sup>o</sup> CURB STOP CO <sup>o</sup> CLEAN OUT	—≧ WATER SERVICE —S SANITARY SERVICE	— GAS — GAS — E — ELECTRICAL
-----------	--	---	---------------------------------

**THE INFORMATION CONTAINED HEREIN IS FOR INTERNAL USE ONLY.  
NOT TO BE RELIED UPON UNLESS CONFIRMED BY THE SITE INSPECTION AND/OR INVESTIGATION**

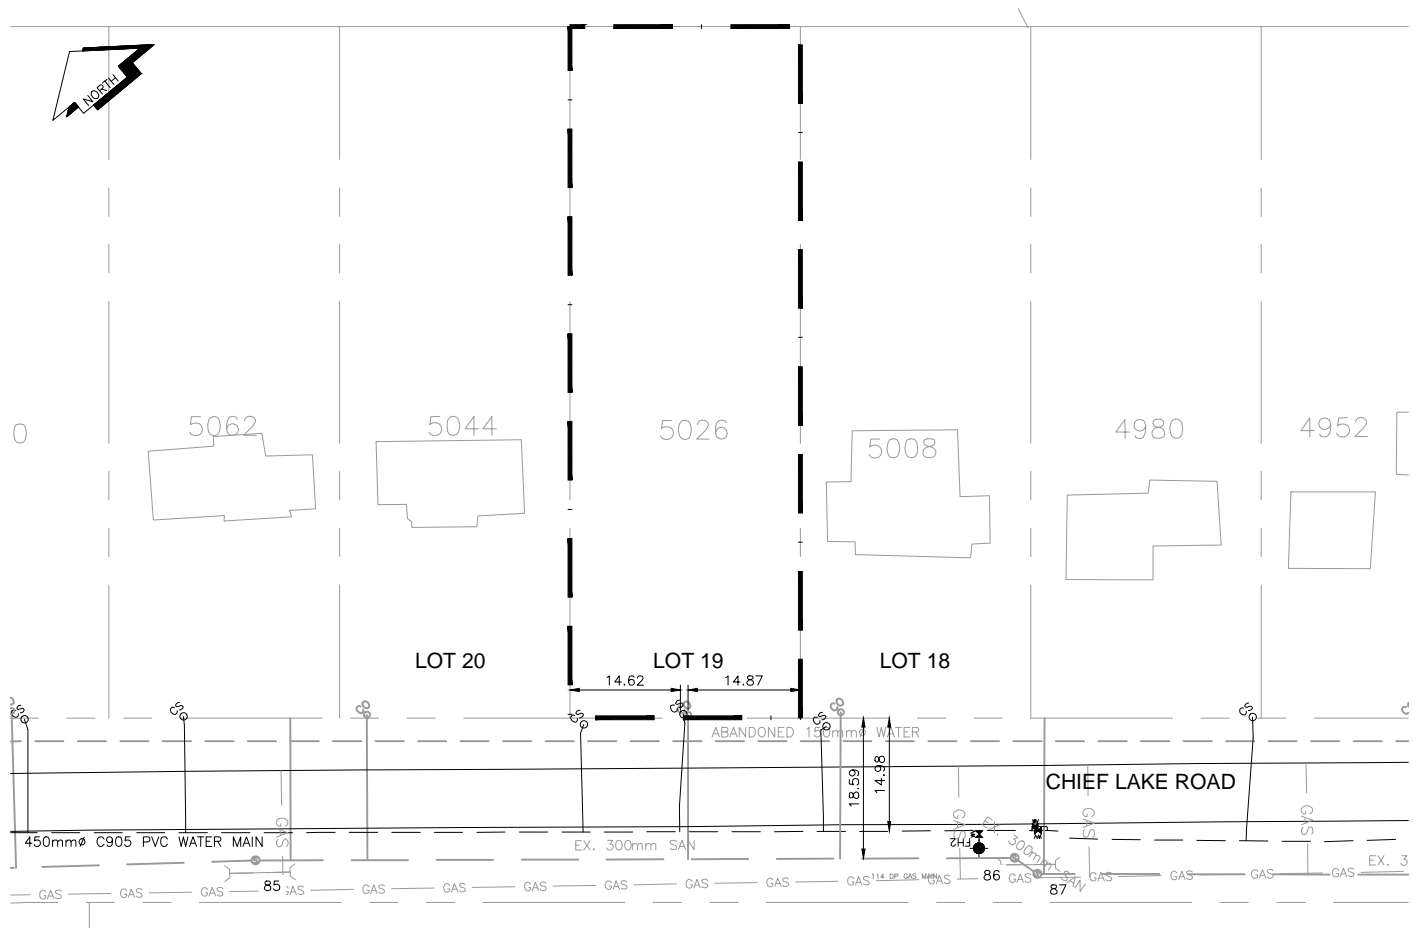

SANITARY, STORM & WATER SERVICE INVERTS	SANITARY	WATER	STORM
1. Distance from San. M.H. <u>86</u> toward San. M.H. <u>85</u> to lot service connection point is:	43.17m	44.26m	
2. Main Size at connection point is	100mmØ	19mmØ	
3. Obvert of main at conn. stub point is	757.43m	760.26m	
4. Obvert at service end is		760.13m	
5. Cover at property line in meters			
6. Survey Date:NOV 2014    Book Ref.:1035-55    By:L&M			

### SANITARY HISTORY:

DATE INSTALLED: -

INSTALLED BY: -

### WATER HISTORY:

DATE INSTALLED: SEPT 2014

INSTALLED BY: CoPG

### STORM HISTORY:

DATE INSTALLED: -

INSTALLED BY: -