

City of Prince George

HISTORY SHEET

PID: 011699833

Scale: 1:1000

Legal: 20

D.L.: 2424

PLAN: 10807

Address: 5044 CHIEF LAKE ROAD

Sanitary Connection: 16646 SIZE: 100mmØ MATERIAL: PVC INV. 760.26m CONNECTED

Water Connection: SIZE: 19mmØ MATERIAL: COPPER INV. 760.58m CONNECTED

Storm Connection: SIZE MATERIAL INV.

Cash Receipt No's: WATER SANITARY STORM

CURB FROM PROPERTY LINE PAVEMENT WIDTH

HYDRO - O/H CONNECTION


TELEPHONE - O/H CONNECTION

GAS -

Information Sheets: -

Comments: CS CURB STOP CO CLEAN OUT WATER SERVICE SANITARY SERVICE GAS E ELECTRICAL

THE INFORMATION CONTAINED HEREIN IS FOR INTERNAL USE ONLY.
NOT TO BE RELIED UPON UNLESS CONFIRMED BY THE SITE INSPECTION AND/OR INVESTIGATION

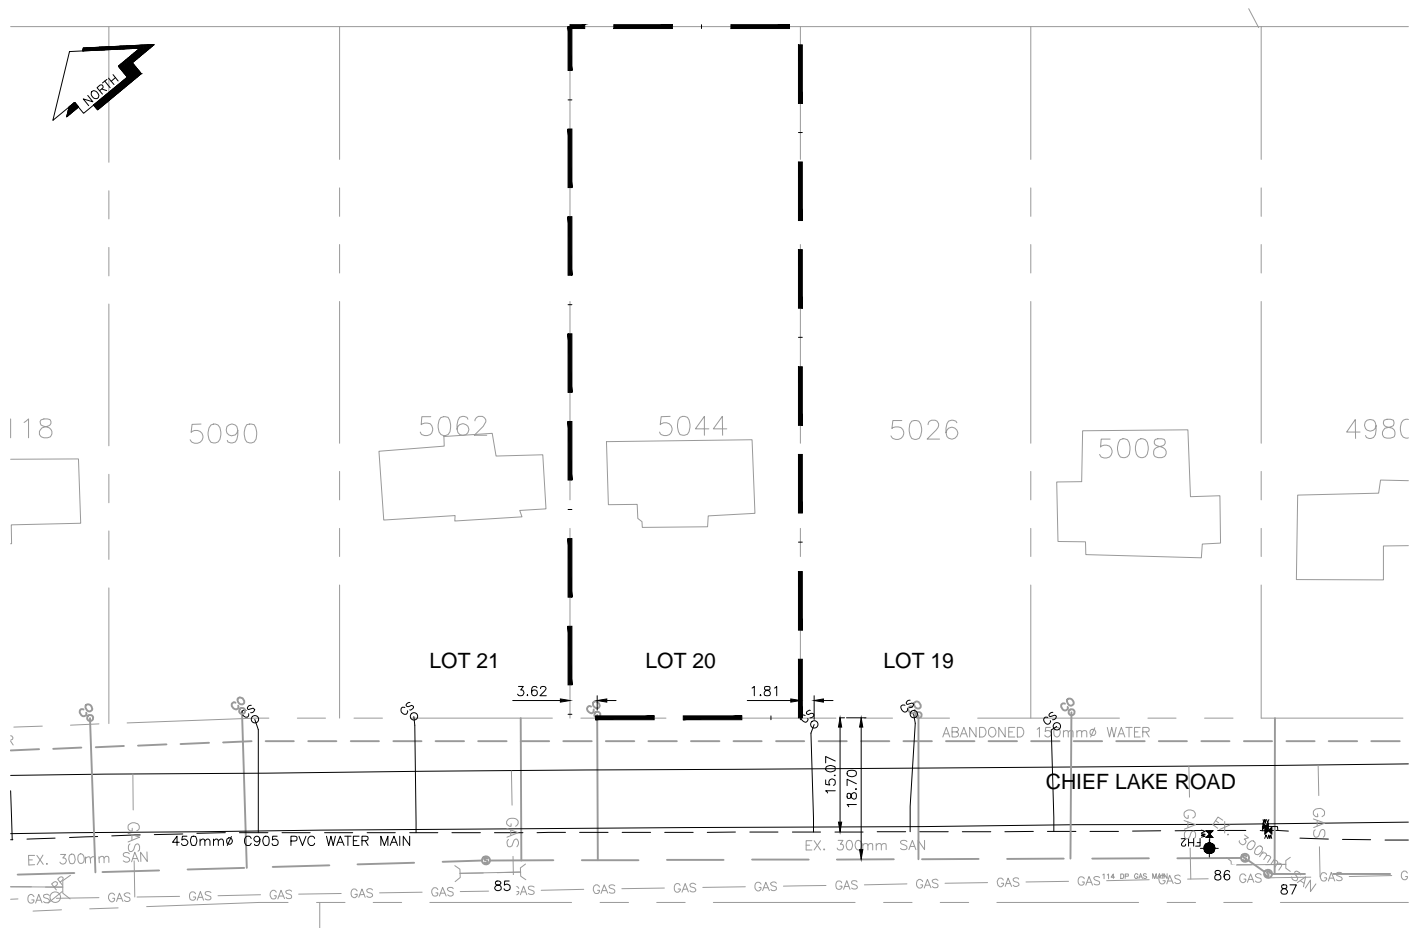

SANITARY, STORM & WATER SERVICE INVERTS	SANITARY	WATER	STORM
1. Distance from San. M.H. <u>86</u> toward San. M.H. <u>85</u> to lot service connection point is:	85.58m	57.04m	
2. Main Size at connection point is	100mmØ	19mmØ	
3. Obvert of main at conn. stub point is	757.57m	760.54m	
4. Obvert at service end is		760.60m	
5. Cover at property line in meters			
6. Survey Date:NOV 2014 Book Ref.:1035-55 By:L&M			

SANITARY HISTORY:

DATE INSTALLED: -

INSTALLED BY: -

WATER HISTORY:

DATE INSTALLED: SEPT 2014

INSTALLED BY: CoPG

WATER CURB STOP IS LOCATED IN FRONT OF LOT 19, 1.81m EAST OF LOT 20 WEST PROPERTY LINE

STORM HISTORY:

DATE INSTALLED: -

INSTALLED BY: -