



City of Prince George History Sheet

PID:	011704594
	011704608
SD/MU:	
WO:	

Civic Address: 1857 Gorse St

Legal Description: Lot: 7, 8 Block: 304 District Lot: 343 Plan: 16864


Service Type	Diameter (mm)	Material	Invert Elev at main (m)	Invert Elev at property line (m)	Invert Elev at service end (m)	Distance into property (m)	Installation Date
Sanitary	100mm	AC	574.36	-	574.73	-	January 1956
Water	20mm	Copper	-	-	-	-	January 1956
Storm	N/A	N/A	-	-	-	-	

Service Connection Location				Sanitary (m)	Storm (m)
Distance from downstream San MH	3315	towards upstream San MH	3211	48.36	
Distance from downstream Stm MH	-	towards upstream Stm MH	-		

Power	Size	Communications	Size	Cable	Size	Gas	Size
BC Hydro	-	Telus	-	Shaw	-	FortisBC	-
Overhead Service		Overhead Service		Overhead Service			

Installed by:	Survey Date:	-
Comments: Water and Sanitary services confirmed April 27, 2017		

NOT TO SCALE The information contained herein is for internal use only.
Not to be relied on unless confirmed by site inspection and/or investigation.

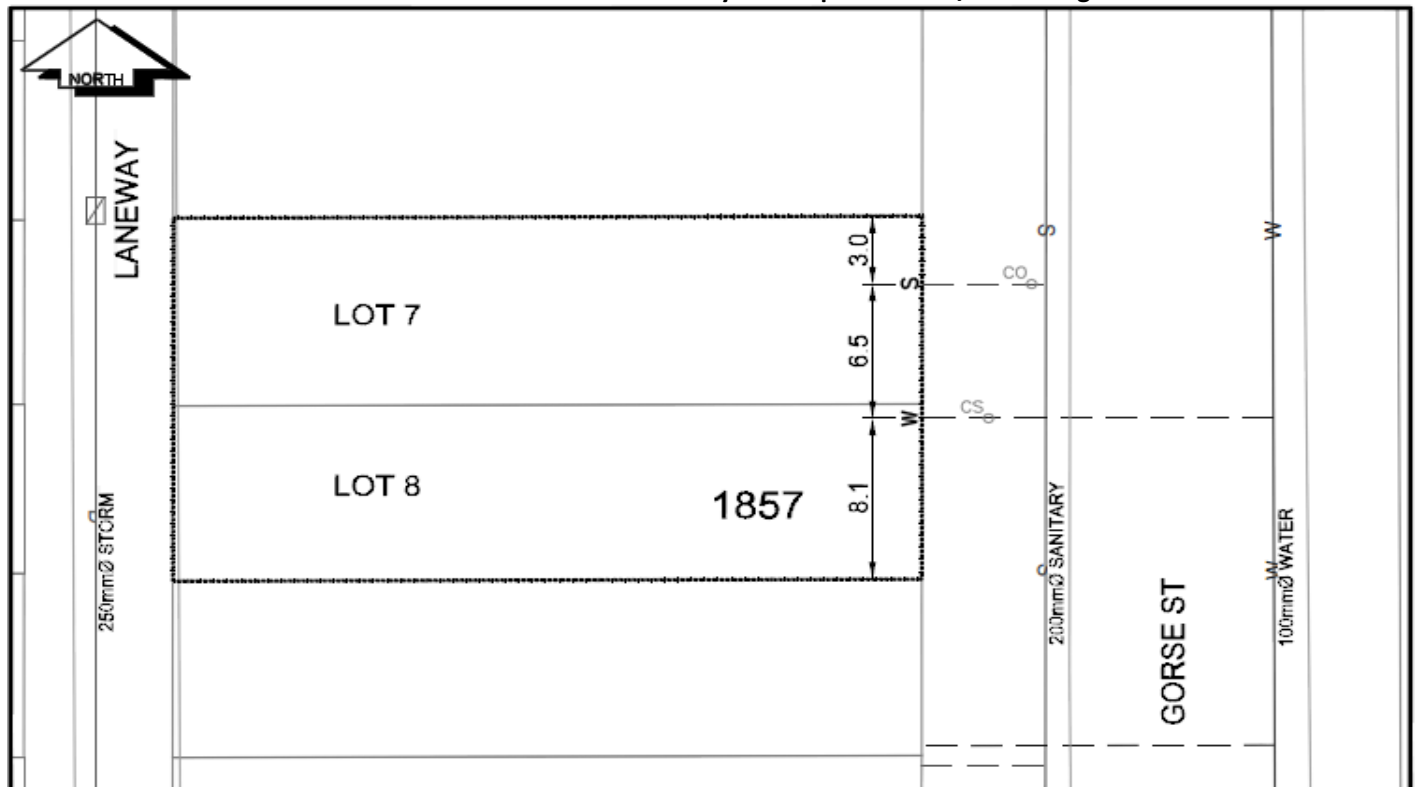

CS ^o	CURB STOP	---	W	WATER SERVICE	---	o	STORM SERVICE
CO ^o	CLEAN OUT	---	S	SANITARY SERVICE	---	G	GAS
⊗	WATER VALVE	⊗		FIRE HYDRANT	---	---	ENCUMBRANCE

NOT TO SCALE