



# City of Prince George History Sheet

PID:	011745801
SD/MU:	
WO:	

Civic Address: 1956 3rd Ave

Legal Description: Lot: 1 District Lot: 343 Plan: 16581


Service Type	Diameter (mm)	Material	Invert Elev at main (m)	Invert Elev at property line (m)	Invert Elev at service end (m)	Distance into property (m)	Installation Date
Sanitary	100mm	AC	-	580.25	-	-	January 1957
Water	50mm	Copper	-	-	-	-	January 1958
Storm (D1)	200mm	AC	-	580.88	-	-	January 1961
Storm (D2)	200mm	AC	-	579.16	-	-	January 1961

Service Connection Location				Sanitary (m)	Storm (m)
Distance from downstream San MH	996	towards upstream San MH	991	77.53	
Distance from downstream Stm MH	-	towards upstream Stm MH	-		

Power	Size	Communications	Size	Cable	Size	Gas	Size
BC Hydro	-	Telus	-	Shaw	-	FortisBC	-
Overhead Service		Overhead Service		Overhead Service			

Installed by:	Survey Date:	-
Comments:		

**NOT TO SCALE** The information contained herein is for internal use only.  
Not to be relied on unless confirmed by site inspection and/or investigation.

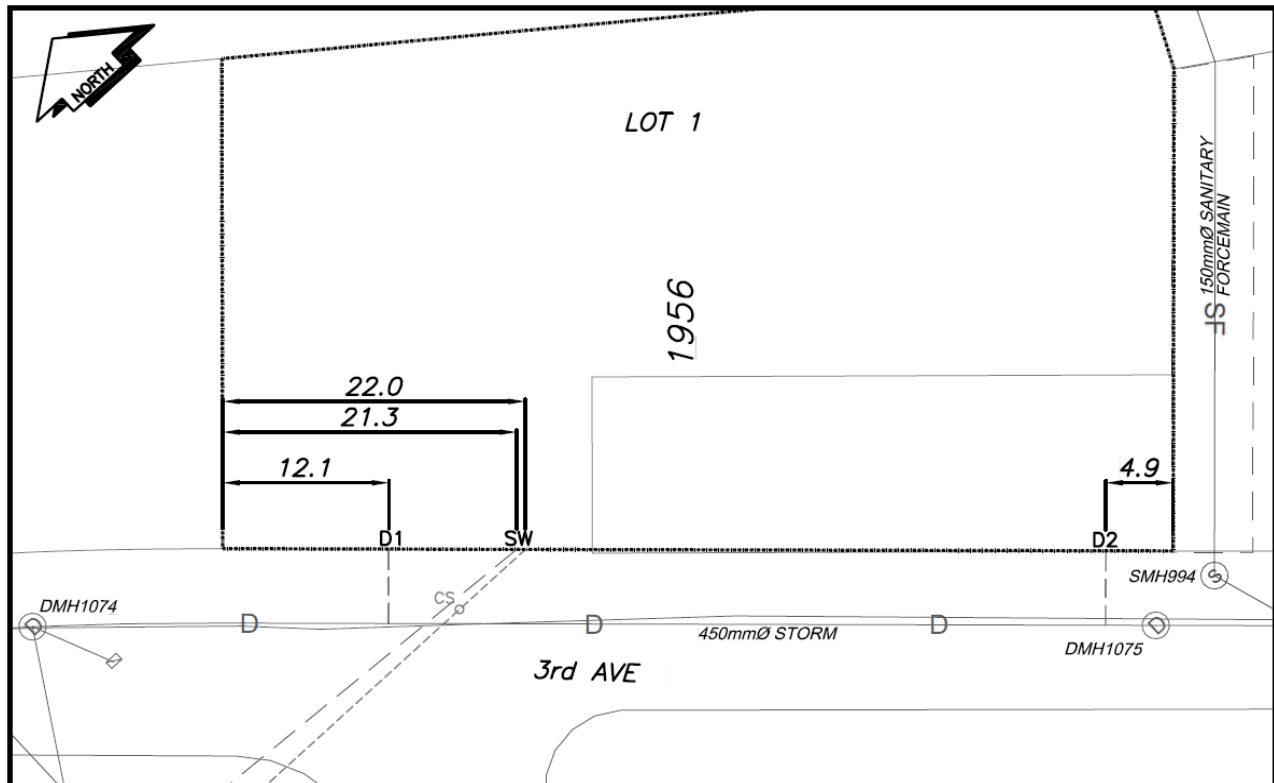

CS <sup>o</sup> CURB STOP	—W— WATER SERVICE	—S— STORM SERVICE
CO <sup>o</sup> CLEAN OUT	- - - - - SANITARY SERVICE	—G— GAS
⊗ WATER VALVE	⊗ FIRE HYDRANT	- - - - - ENCUMBRANCE

**NOT TO SCALE**