



City of Prince George History Sheet

PID:	011746432
SD/MU:	
WO:	

Civic Address: 4248 Churchill Rd

Legal Description: Lot: 34 District Lot: 7634 Plan: 16573


Service Type	Diameter (mm)	Material	Invert Elev at main (m)	Invert Elev at property line (m)	Invert Elev at service end (m)	Distance into property (m)	Installation Date
Sanitary	100mm	PVC	-	-	-	-	December 1995
Water	20mm	Copper	597.62	598.30	599.18	1.00	February 1971
Storm	N/A	N/A	-	-	-	-	

Service Connection Location				Sanitary (m)	Storm (m)
Distance from downstream San MH	1532	towards upstream San MH	1552	38.09	
Distance from downstream Stm MH	-	towards upstream Stm MH	-		

Power	Size	Communications	Size	Cable	Size	Gas	Size
BC Hydro	-	Telus	-	Shaw	-	FortisBC	-
Overhead Service		Overhead Service		Overhead Service			

Installed by:	Water service installed by City of Prince George forces	Survey Date:	-
Comments:			

NOT TO SCALE The information contained herein is for internal use only.
Not to be relied on unless confirmed by site inspection and/or investigation.

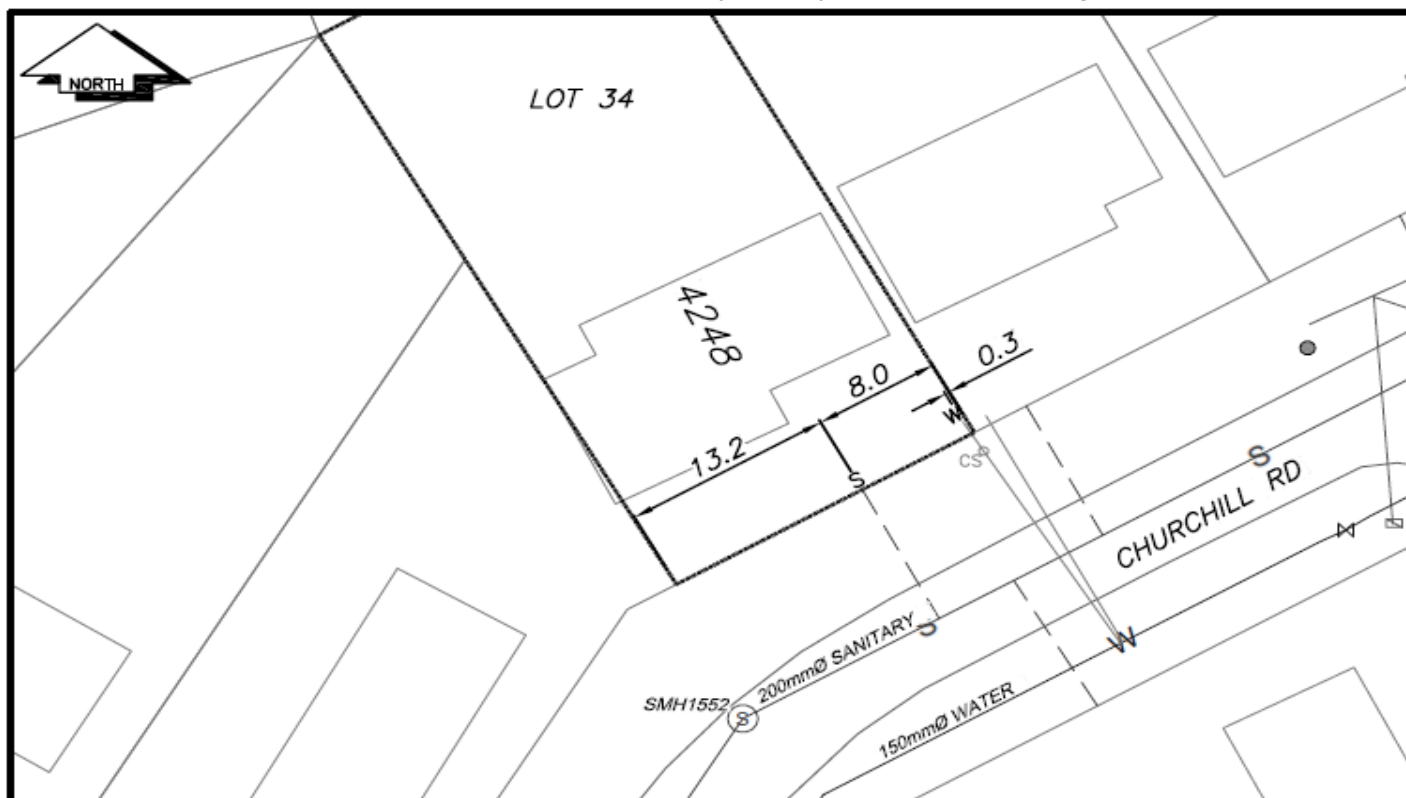

CS	CURB STOP	—S—	WATER SERVICE	—S—	STORM SERVICE
CO	CLEAN OUT	—S—	SANITARY SERVICE	—G—	GAS
WV	WATER VALVE	—F—	FIRE HYDRANT	---	ENCUMBRANCE

NOT TO SCALE