



City of Prince George History Sheet

PID:	011775327
SD/MU:	
WO:	

Civic Address: 137, 141 Pioneer Ave

Legal Description: Lot: 011775327 District Lot: 2610 Plan: 16510


Service Type	Diameter (mm)	Material	Invert Elev at main (m)	Invert Elev at property line (m)	Invert Depth at service end (m)	Distance into property (m)	Installation Date
Sanitary	100mm	AC	-	602.12	1.90	-	January 1966
Water	20mm	Copper	-	-	-	-	January 1966
Storm	N/A	N/A	-	-	-	-	

Service Connection Location	Sanitary (m)	Storm (m)
100mm Sanitary service connected to San MH2568	-	
Distance from downstream Stm MH - towards upstream Stm MH -		

Power	Size	Communications	Size	Cable	Size	Gas	Size
BC Hydro	-	Telus	-	Shaw	-	FortisBC	-
Underground Service		Underground Service		Underground Service			

Installed by:	Survey Date:	-
Comments: Water service locate done January 2017		

NOT TO SCALE The information contained herein is for internal use only.
Not to be relied on unless confirmed by site inspection and/or investigation.

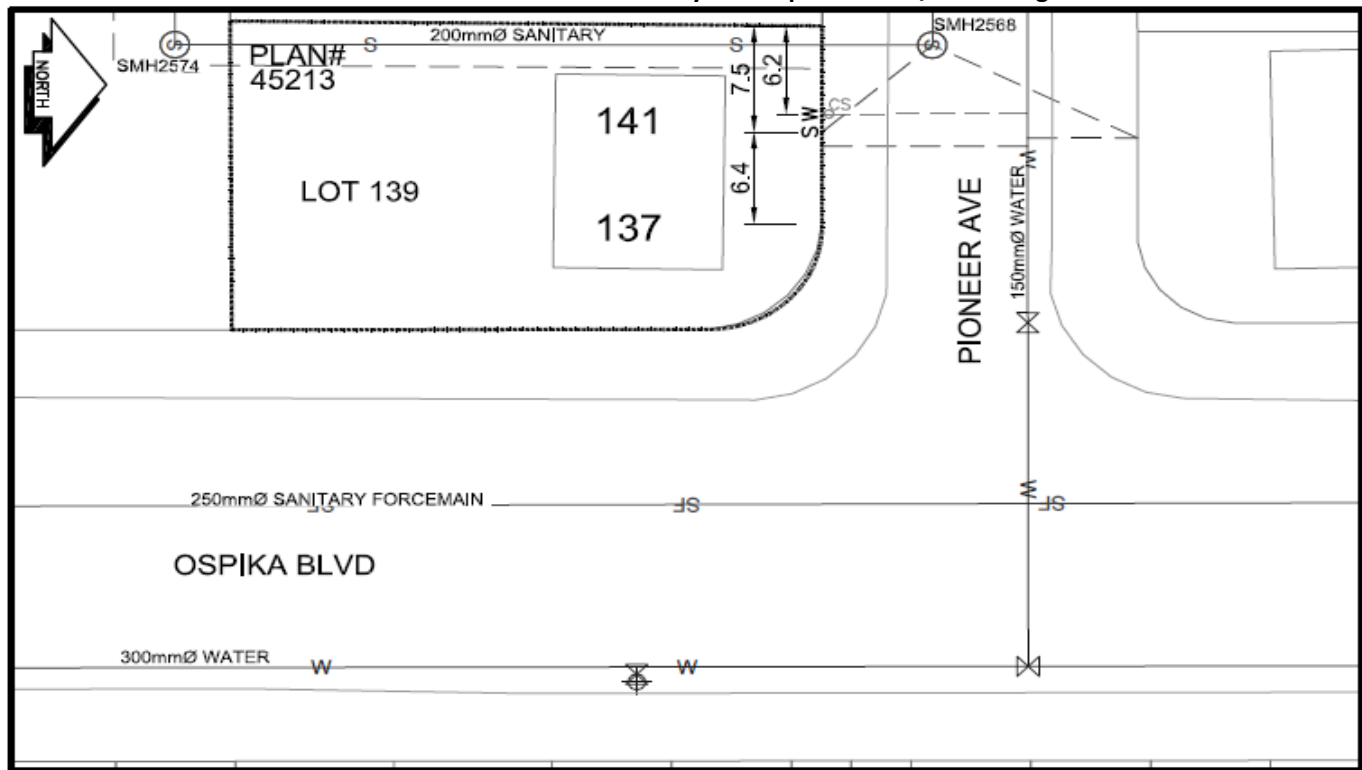

CS ^o CURB STOP	--- -- -- -- -- WATER SERVICE	--- -- -- -- -- STORM SERVICE
CO ^o CLEAN OUT	--- -- -- -- -- SANITARY SERVICE	--- G --- GAS
⊗ WATER VALVE	⊗ FIRE HYDRANT	--- -- -- -- -- ENCUMBRANCE

NOT TO SCALE