


Lot Servicing

1920 JUNIPER ST

PID: 011783052 & 011783079

Lot: 17 & 18 **Block:** 343, **Plan:** 1268, **DL:** 343

SERVICE	SIZE	MATERIAL	INSTALLED DATE	LOCATION	DETAILS
WATER	13MM	CU		NO LOCATION	CONNECTION NUMBER 788
SANITARY	UNKNOWN	UNKNOWN		1.828M S OF NW COR PL	CLEANOUT 2.103M S OF N PL

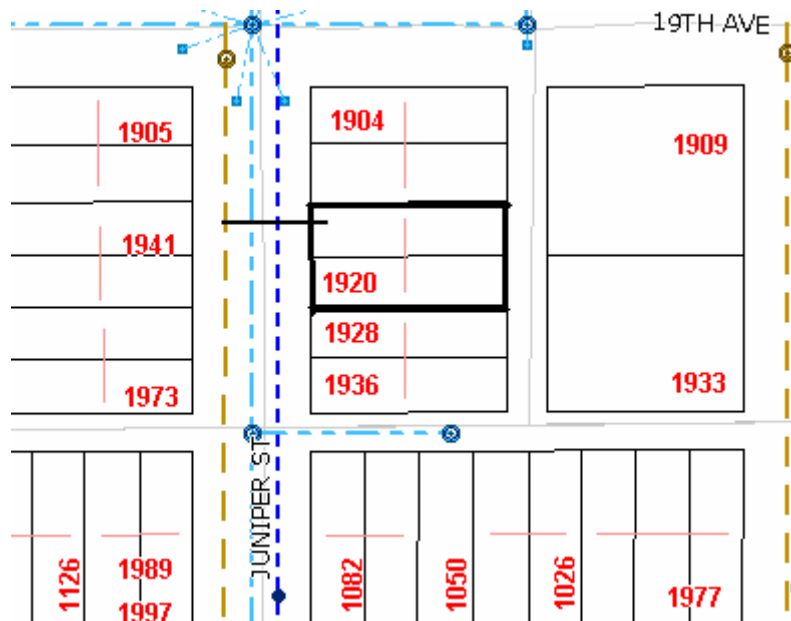

Accuracy not guaranteed unless confirmed by site inspection and/or investigation.
Connection location between main and property line only.