


Lot Servicing

1920 JUNIPER ST

PID: 011783052 & 011783079

Lot: 17 & 18 **Block:** 343, **Plan:** 1268, **DL:** 343

| SERVICE | SIZE | MATERIAL | INSTALLED DATE | LOCATION | DETAILS |
|----------|---------|----------|----------------|-----------------------|---------------------------|
| WATER | 13MM | CU | | NO LOCATION | CONNECTION NUMBER 788 |
| SANITARY | UNKNOWN | UNKNOWN | | 1.828M S OF NW COR PL | CLEANOUT 2.103M S OF N PL |

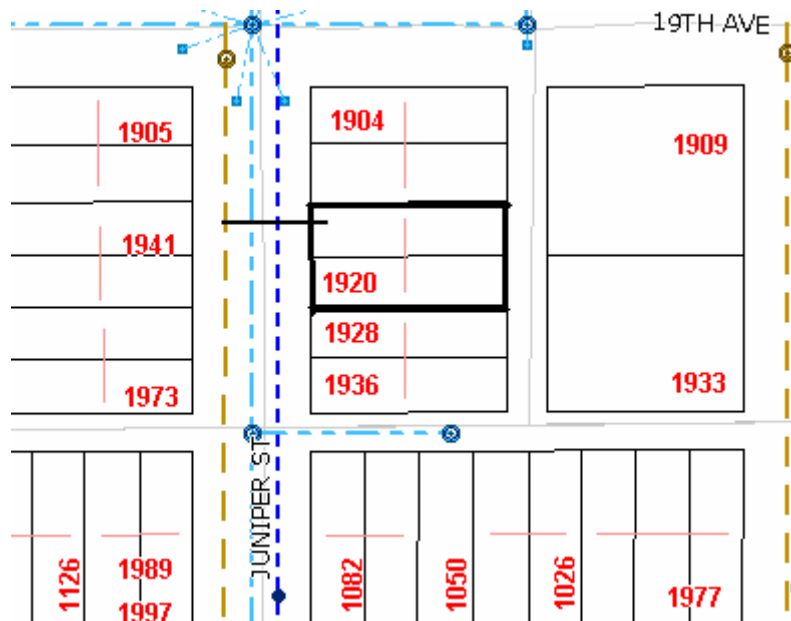

Accuracy not guaranteed unless confirmed by site inspection and/or investigation.
Connection location between main and property line only.