



# City of Prince George History Sheet

PID:	011810891
SD/MU:	
WO:	

Civic Address: 7915 Rosewood Pl

Legal Description: Lot: B District Lot: 1599 Plan: 16467


Service Type	Diameter (mm)	Material	Invert Elev at main (m)	Invert Elev at property line (m)	Invert Elev at service end (m)	Distance into property (m)	Installation Date
Sanitary	100mm	AC	-	-	-	-	December 1965
Water	20mm	Copper	-	-	-	-	December 1994
Storm	N/A	N/A	-	-	-	-	

Service Connection Location				Sanitary (m)	Storm (m)
Distance from downstream San MH	4651	towards upstream San MH	4611	58.70	
Distance from downstream Stm MH	-	towards upstream Stm MH	-		

Power	Size	Communications	Size	Cable	Size	Gas	Size
BC Hydro	-	Telus	-	Shaw	-	FortisBC	-
Overhead Service		Overhead Service		Overhead Service			

Installed by:	Survey Date:	-
Comments:		

**NOT TO SCALE** The information contained herein is for internal use only.  
Not to be relied on unless confirmed by site inspection and/or investigation.

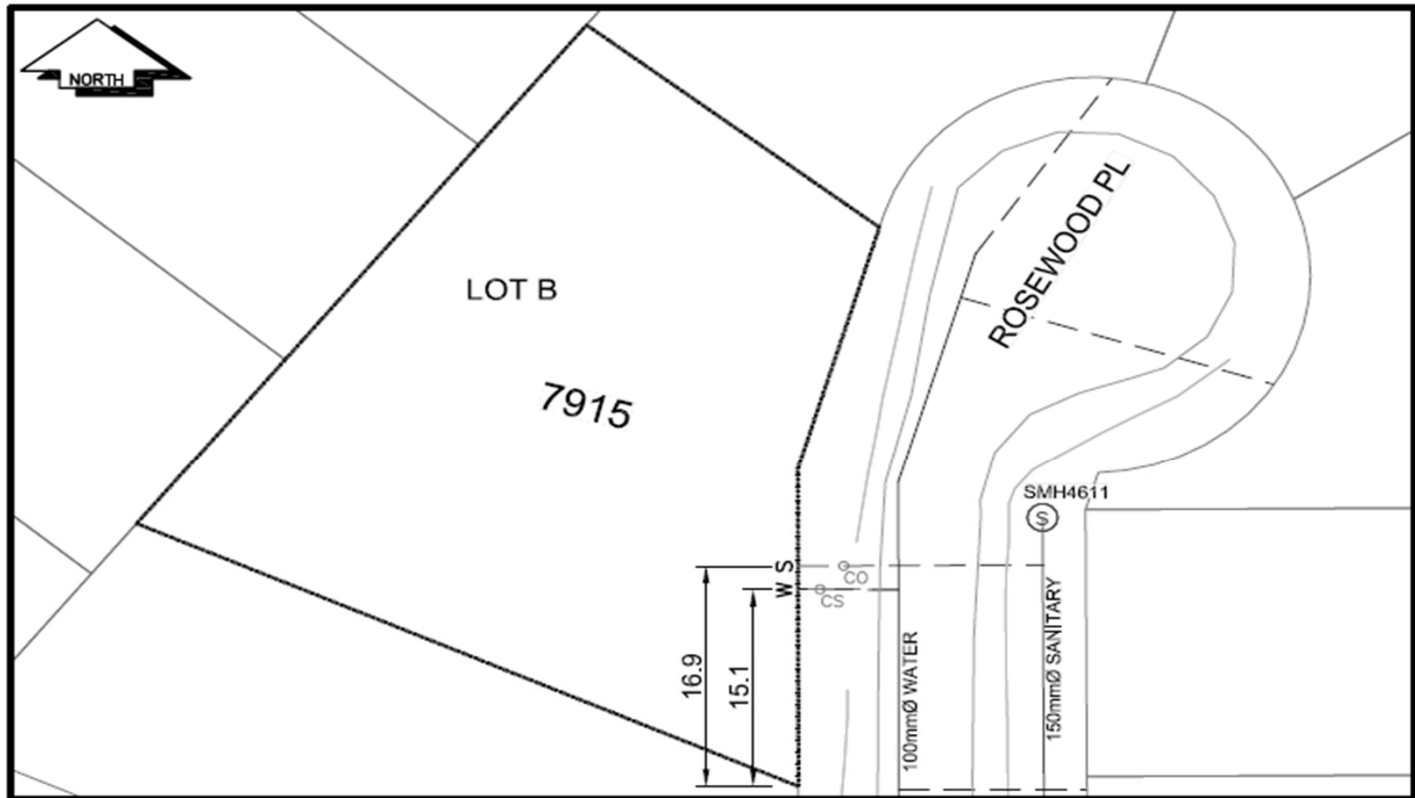

CS CURB STOP	--- W --- WATER SERVICE	--- S --- STORM SERVICE
CO CLEAN OUT	--- S --- SANITARY SERVICE	--- G --- GAS
WV WATER VALVE	FH FIRE HYDRANT	--- ENCUMBRANCE

**NOT TO SCALE**