



# City of Prince George History Sheet

PID:	011849282
	011849312
SD/MU:	
WO:	

Civic Address: 1706 Oak St

Legal Description: Lot: 19, 20 Block: 284 District Lot: 343 Plan: 1268


Service Type	Diameter (mm)	Material	Invert Elev at main (m)	Invert Elev at property line (m)	Invert Elev at service end (m)	Distance into property (m)	Installation Date
Sanitary	100mm	AC	-	-	-	-	December 1956
Water	20mm	Copper	-	-	-	-	December 1956
Storm	N/A	N/A	-	-	-	-	

Service Connection Location				Sanitary (m)	Storm (m)
Distance from downstream San MH	3180	towards upstream San MH	3182	99.20	
Distance from downstream Stm MH	-	towards upstream Stm MH	-		

Power	Size	Communications	Size	Cable	Size	Gas	Size
BC Hydro	-	Telus	-	Shaw	-	FortisBC	-
Overhead Service		Overhead Service		Overhead Service			

Installed by:		Survey Date:	-
Comments:	Water service confirmed June 21, 2017		

**NOT TO SCALE** The information contained herein is for internal use only.  
Not to be relied on unless confirmed by site inspection and/or investigation.

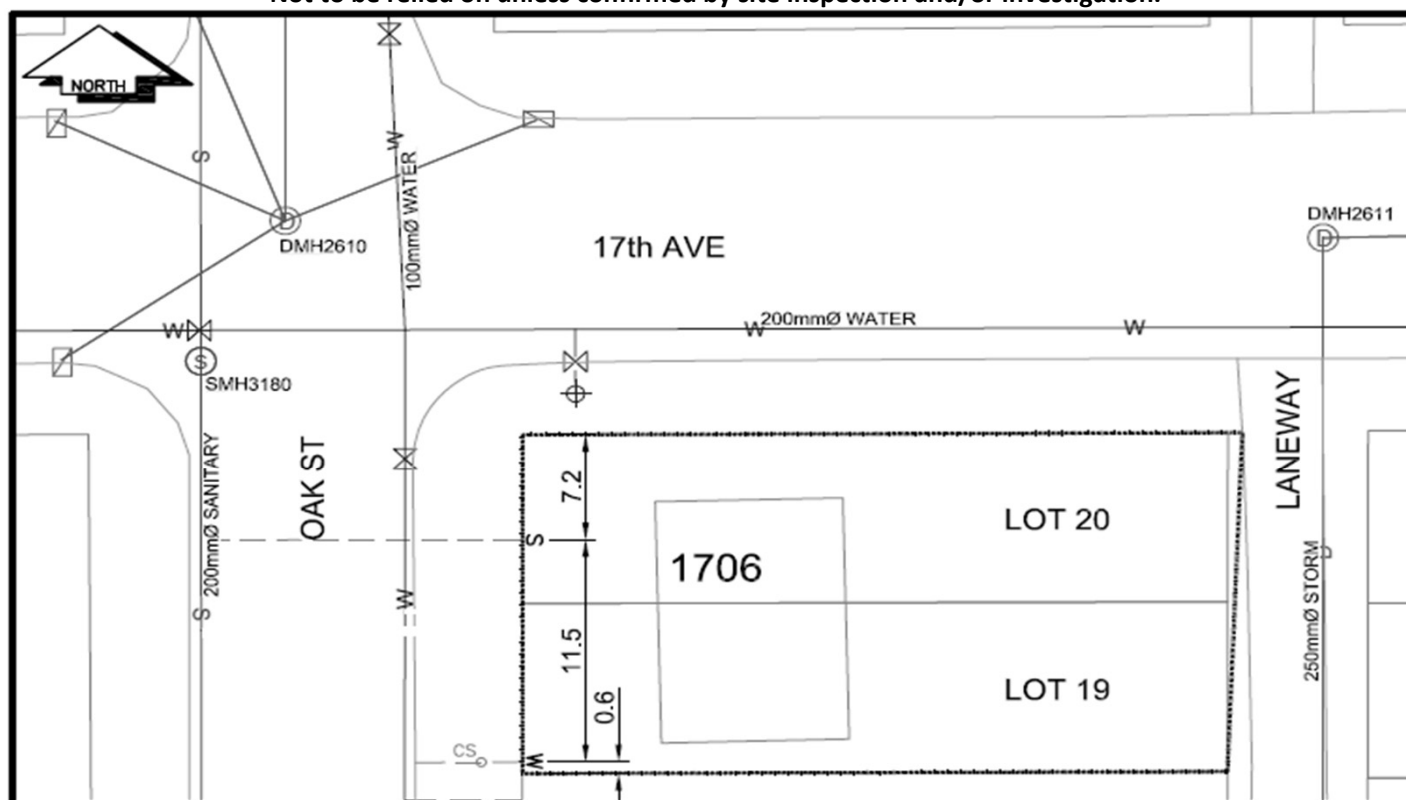

CS <sup>o</sup> CURB STOP	--- W WATER SERVICE	--- S SANITARY SERVICE	--- G GAS
CO <sup>o</sup> CLEAN OUT	--- S SANITARY SERVICE	--- G GAS	--- ENCUMBRANCE
WATER VALVE	FIRE HYDRANT		

**NOT TO SCALE**