



# City of Prince George History Sheet

PID:	011852941
	011853018
	011853077
	011853115
	011853336
SD/MU:	
WO:	

Civic Address: 1753 Upland St

Legal Description: Lot: 16 - 19, B Block: 274 District Lot: 343 Plan: 1268


Service Type	Diameter (mm)	Material	Invert Elev at main (m)	Invert Elev at property line (m)	Invert Elev at service end (m)	Distance into property (m)	Installation Date
Sanitary (S1)	150mm	AC	-	-	-	-	December 1960
Sanitary (S2)	150mm	AC	-	-	-	-	December 1960
Water	40mm	Copper	-	-	-	-	December 1960
Storm	N/A	N/A	-	-	-	-	

Service Connection Location				Sanitary (m)	Storm (m)
Distance from downstream San MH	3170	towards upstream San MH	3173	83.76	
Distance from downstream San MH	3170	towards upstream San MH	3173	85.32	

Power	Size	Communications	Size	Cable	Size	Gas	Size
BC Hydro	-	Telus	-	Shaw	-	FortisBC	-
Overhead Service		Overhead Service		Overhead Service			

Installed by:	Survey Date:	-
Comments:		

**NOT TO SCALE** The information contained herein is for internal use only.  
Not to be relied on unless confirmed by site inspection and/or investigation.

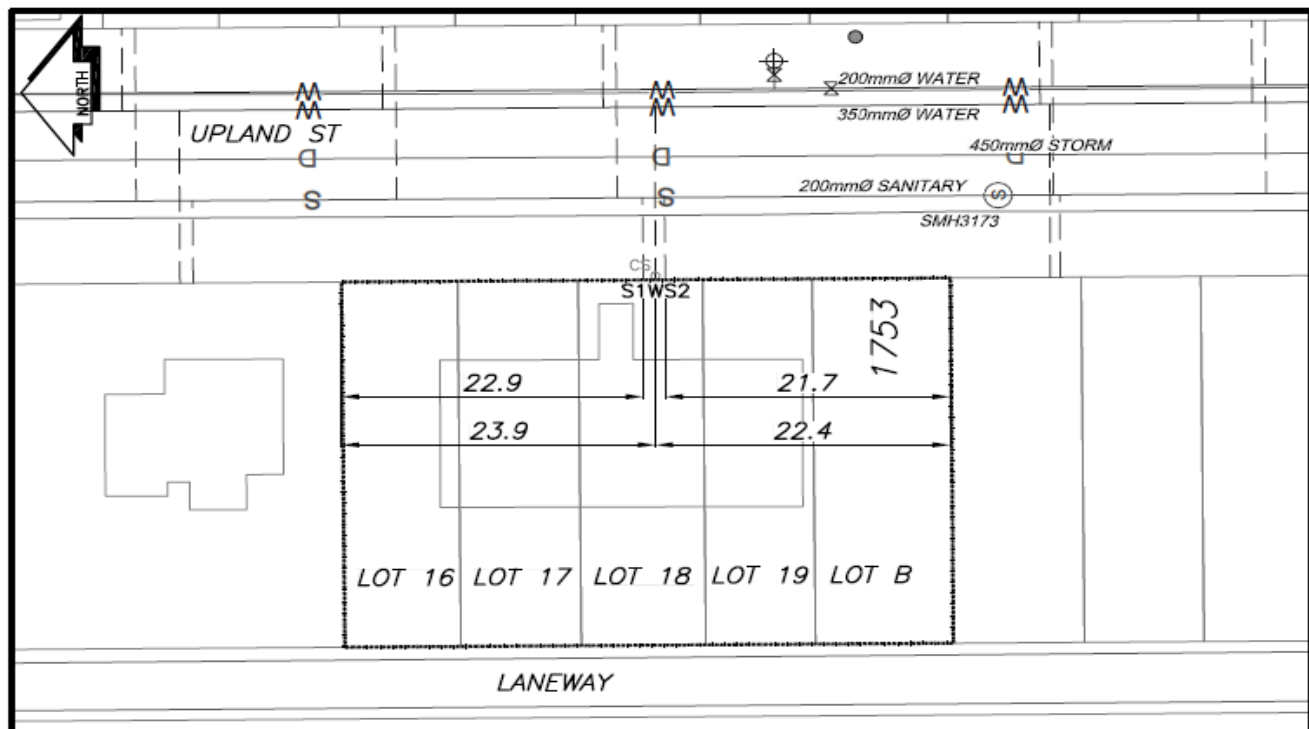

CS <sup>o</sup> CURB STOP	—X— WATER SERVICE	—o— STORM SERVICE
CO <sup>o</sup> CLEAN OUT	- - - - - SANITARY SERVICE	—G— GAS
X WATER VALVE	—X— FIRE HYDRANT	- - - - - ENCUMBRANCE

**NOT TO SCALE**