



City of Prince George History Sheet

PID:	011858346
	011858338
	011858320
	011858311
SD/MU:	101923
WO:	93739

Civic Address: 1744 Spruce St

Legal Description: Lot: 13 - 16 Block; 279 District Lot: 343 Plan: 1268


Service Type	Diameter (mm)	Material	Invert Elev at main (m)	Invert Elev at property line (m)	Invert Elev at service end (m)	Distance into property (m)	Installation Date
Sanitary	100mm	AC	-	-	-	-	December 1966
Water	40mm	Copper	-	-	-	-	July 2017
Storm	100mm	PVC	-	-	-	-	December 1966

Service Connection Location				Sanitary (m)	Storm (m)
Distance from downstream San MH	3168	towards upstream San MH	3174	51.10	
Distance from downstream Stm MH	2477	towards upstream Stm MH	1475		71.21

Power	Size	Communications	Size	Cable	Size	Gas	Size
BC Hydro	-	Telus	-	Shaw	-	FortisBC	-
Overhead Service		Overhead Service		Overhead Service			

Installed by:	City of Prince George forces	Survey Date:	-
Comments:			

NOT TO SCALE The information contained herein is for internal use only.
Not to be relied on unless confirmed by site inspection and/or investigation.

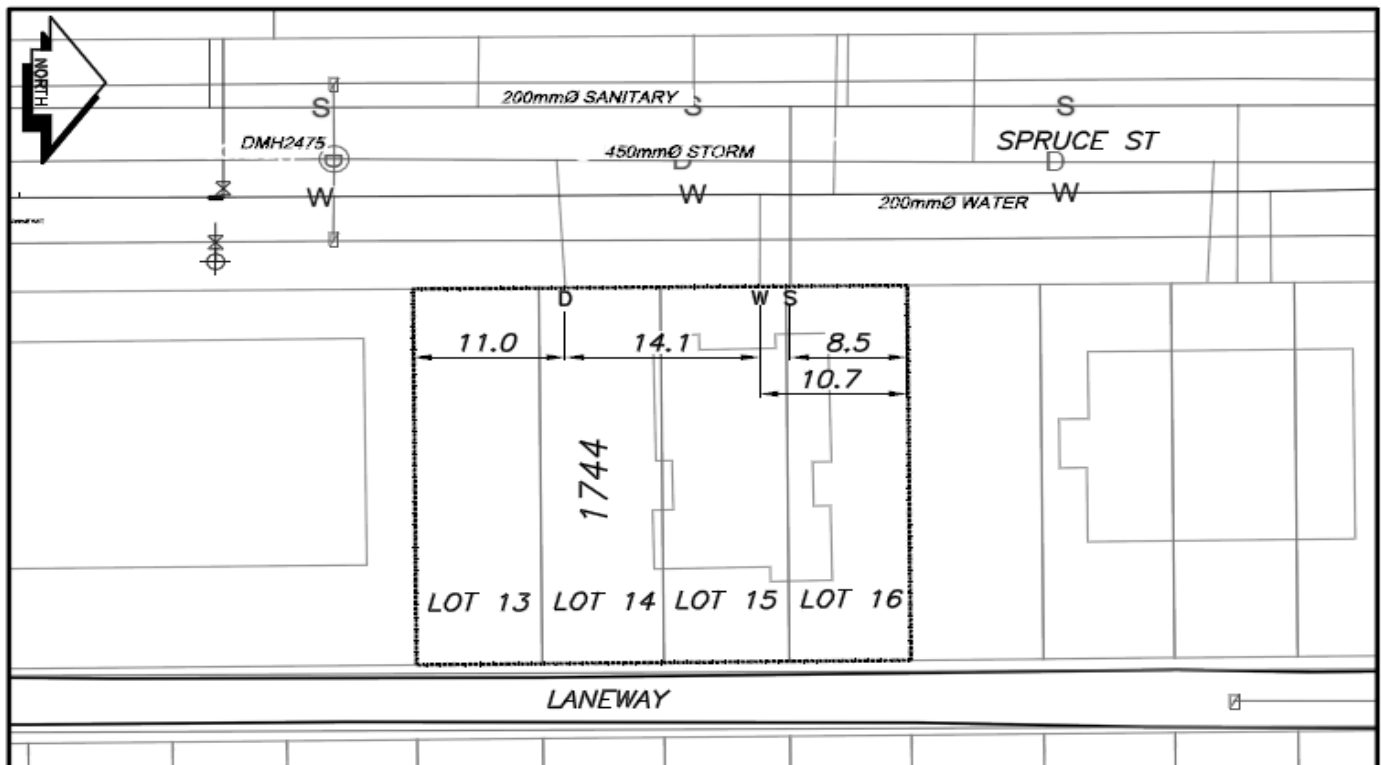

CS ^o CURB STOP	— — — — — WATER SERVICE	— — — — — STORM SERVICE
CO ^o CLEAN OUT	— — — — — SANITARY SERVICE	— — — — — GAS
⊗ WATER VALVE	⊗ FIRE HYDRANT	— — — — — ENCUMBRANCE

NOT TO SCALE