



City of Prince George History Sheet

PID:	011872471
SD/MU:	
WO:	

Civic Address: 1282 Aleza Cres

Legal Description: Lot: 129 District Lot: 2507 Plan: 16227


Service Type	Diameter (mm)	Material	Invert Elev at main (m)	Invert Elev at property line (m)	Invert Depth at service end (m)	Distance into property (m)	Installation Date
Sanitary	100mm	AC	-	601.33	2.34	-	December 1965
Water	20mm	Copper	-	-	-	-	December 1972
Storm	N/A	N/A	-	-	-	-	

Service Connection Location	Sanitary (m)	Storm (m)
100mm Sanitary service connected to San MH674	-	
Distance from downstream Stm MH - towards upstream Stm MH -		

Power	Size	Communications	Size	Cable	Size	Gas	Size
BC Hydro	-	Telus	-	Shaw	-	FortisBC	-
Underground Service		Underground Service		Underground Service			

Installed by:		Survey Date:	-
Comments:	Water service locate confirmed July 2017.		

NOT TO SCALE The information contained herein is for internal use only.
Not to be relied on unless confirmed by site inspection and/or investigation.

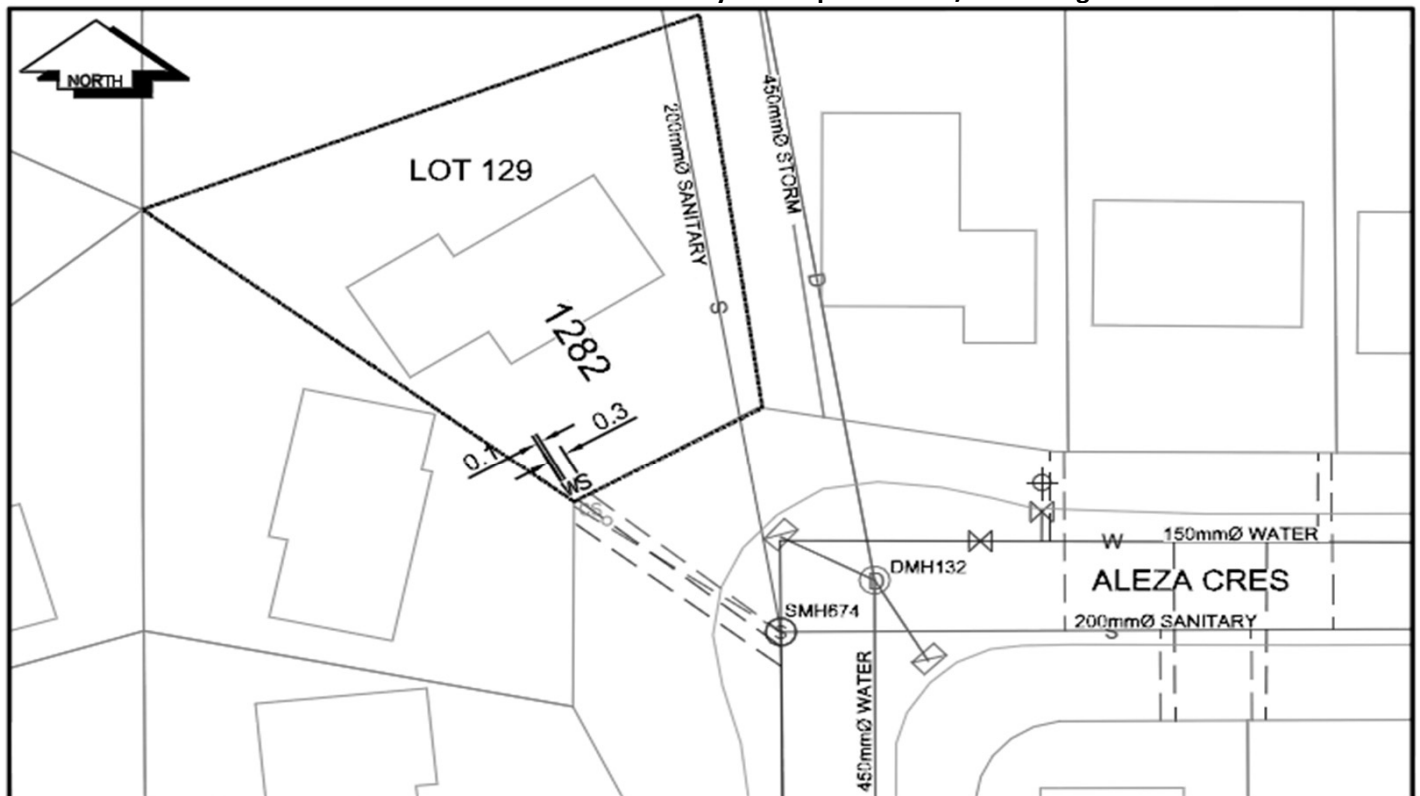

CS ^o CURB STOP	--- W WATER SERVICE	--- S STORM SERVICE
CO ^o CLEAN OUT	--- S SANITARY SERVICE	--- G GAS
⊗ WATER VALVE	⊗ FIRE HYDRANT	--- ENCUMBRANCE

NOT TO SCALE